

WAYNE

U

8-14-78

MISSISSIPPI BOARD OF WATER COMMISSIONERS 416 North State Street Jackson, Mississippi 39201

WATER WELL DRILLERS LOG

MCGILWAIN WATER WELL SERVICE

Aug 14 1978 date well completed

WAYNESBORO, MISS. 39367

Wayne county well located

LANDOWNER:	description of formations encountered	from	to
Ben Flemings Buckatunna Miss (mailing address)			
WELL LOCATION:	Sand	10	25
sec. 5 T 7 N R 5 E 12 miles SE of Wboro (distance) (direction) (nearest town)	Sand & Clay	25	45
WELL PURPOSE: Home (home, irrigation, municipal, industrial)	Clay	45	60
WELL COMPLETION DATA:	Sand	60	62
(1) diameter (inches) 2"	Clay	62	94
(2) total depth (feet) 133'	Sand	94	97
(3) static water level (feet) 99' below top of ground	Clay	97	120
(4) casing PVC @ 128' (material) (depth)	Fine Sand	120	125
2" If telescope see back. (size)	Med Sand	125	133
(5) screen 5' 128' (length) (depth to top)			
2" PVC .008 (size) (material)			
(6) pump 1 5 (HP) (yield gpm)			
220 AC (type power)			
(7) electric log No (yes or no)			
(organization running log)			
(8) how well bottom plugged			
DRILLERS REMARKS:			


RECEIVED

OCT 26 1978

MISS. Bd. OF WATER COMMISSIONERS

If well telescopes please sketch and show depths.

GROUND LEVEL

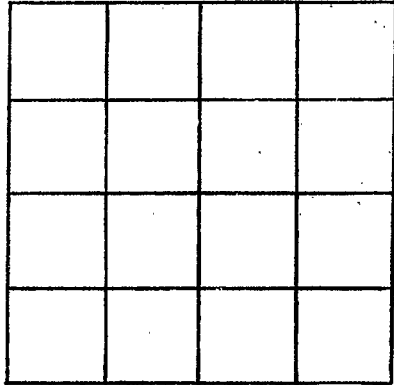

SECTION _____

Please indicate well location X.

ADDITIONAL INFORMATION

If more than one screen,
show locations of each on sketch.