

**MISSISSIPPI
BOARD OF WATER COMMISSIONERS**
416 North State Street
Jackson, Mississippi 39201

WAYNE

U 2027

11-06-78

WATER WELL DRILLERS LOG

MCILWAIN WATER WELL SERVICE

Nov. 6 1978
date well completed

RT. 2 BOX 37

firm name

Wayne

county well located

WAYNESBORO, MISS. 39367


LANDOWNER:	description of formations encountered	from	to
Mr. W. L. McInnis Waynesboro, MS. (mailing address)			
WELL LOCATION: sec. 7 T. 7 N R. 5 W 5 miles N Buckatanwa (distance) (direction) (nearest town)	Clay	13	17
WELL PURPOSE: home (home, irrigation, municipal, industrial)	Sand	17	18
WELL COMPLETION DATA: (1) diameter (inches) 2" (2) total depth (feet) 85' (3) static water level (feet) 63' below top of ground. (4) casing PVC 80' (material) (depth) 2" if telescope see back. (size) (5) screen 5' 80' (length) (depth to top) 2" PVC .008 (size) (material) (6) pump 1 8 (HP) (yield gpm) 220 AC (type power) (7) electric log NO (yes or no) (organization running log) (8) how well bottom plugged	Clay	18	27
	Sand; fine & med.	27	28
	Clay	28	65
	Sand	65	66
	Clay	66	72
	Sand & Clay	72	74
	Sand	74	85
DRILLERS REMARKS:			

RECEIVED
JAN 2 1978

MISS. BD. OF WATER COMM

If well telescopes please
sketch and show depths.

GROUND LEVEL

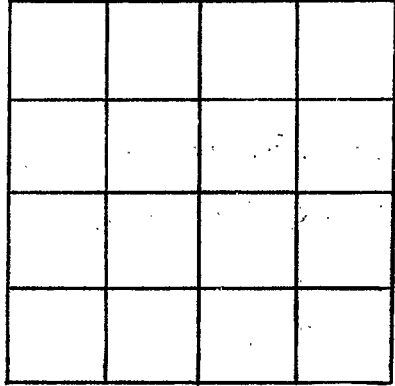

SECTION _____

Please indicate well location X.

ADDITIONAL INFORMATION

2890

If more than one screen,
show locations of each on sketch.