

WAYNE  
 U 2030  
 04-16-79

MISSISSIPPI  
 BOARD OF WATER COMMISSIONERS  
 416 North State Street  
 Jackson, Mississippi 39201

WATER WELL DRILLERS LOG  
 McILWAIN WATER WELL SERVICE

April 16 1979  
 date well completed

RT 2, BOX 37

Wayne  
 county well located

WAYNESBORO, MISS. 39367

| LANDOWNER:   | description of formations encountered | from | to |
|--|---------------------------------------|------|----|
| W T HARRIS   | SAND                                  | 0    | 5  |
| Waynesboro Miss.<br>(mailing address)  | Clay                                  | 5    | 10 |
| WELL LOCATION:   | SAND                                  | 10   | 14 |
| sec <u>3</u> T <u>7</u> N R <u>5</u> E   | Clay                                  | 14   | 28 |
| <u>15</u> miles <u>SE</u> of <u>W'boro</u>   | SAND & CLAY                           | 28   | 38 |
| (distance) (direction) (nearest town)  | Med SAND                              | 38   | 43 |
| WELL PURPOSE: <u>Home</u><br>(home, irrigation, municipal, industrial)                     |                                       |      |    |
| WELL COMPLETION DATA:  |                                       |      |    |
| (1) diameter (inches) <u>2"</u>  |                                       |      |    |
| (2) total depth (feet) <u>45'</u>  |                                       |      |    |
| (3) static water level (feet) <u>22'</u> <sup>below</sup> / <sub>above</sub> top of ground |                                       |      |    |
| (4) casing <u>PVC</u> <u>40'</u><br>(material) (depth)                                     |                                       |      |    |
| <u>2"</u><br>(size) if telescope see back.   |                                       |      |    |
| (5) screen <u>5'</u> <u>40'</u><br>(length) (depth to top)                                 |                                       |      |    |
| <u>2"</u> <u>PVC .008</u><br>(size) (material)   |                                       |      |    |
| (6) pump _____<br>(HP) (yield gpm)   |                                       |      |    |
| _____ (type power)   |                                       |      |    |
| (7) electric log <u>No</u><br>(yes or no)  |                                       |      |    |
| _____ (organization running log)   |                                       |      |    |
| (8) how well bottom plugged _____  |                                       |      |    |

DRILLERS REMARKS:


Mississippi Board of Water Comm.

APR 21 1979

RECEIVED

If well telescopes please sketch and show depths.

GROUND LEVEL

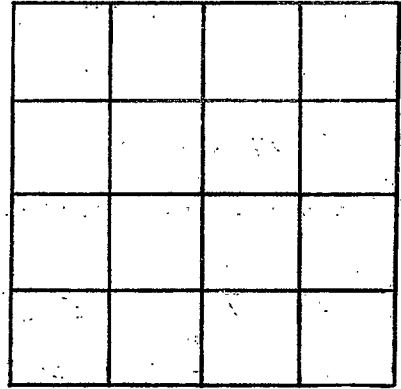

SECTION \_\_\_\_\_

Please indicate well location X.

ADDITIONAL INFORMATION

If more than one screen, show locations of each on sketch.