

WAYNE
 U 2031
 1-19-79

MISSISSIPPI
 BOARD OF WATER COMMISSIONERS
 416 North State Street
 Jackson, Mississippi 39201

WATER WELL DRILLERS LOG

Jan 19 1979 date well completed
 Route Drilling Corp firm name
 Wayne county well located

LANDOWNER: <u>Murtle Rosen</u>	description of formations encountered	from	to
(mailing address)			
<u>P.O. Box 81</u>	<u>sand</u>	<u>0</u>	<u>15</u>
<u>Buckatunna Miss</u>	<u>clay</u>	<u>15</u>	<u>16</u>
	<u>sand</u>	<u>16</u>	<u>23</u>
	<u>clay on clay</u>		

WELL LOCATION: SE/NE
 sec. 30 T 7 N R 5 E
1/2 miles NE of Buckatunna
 (distance) (direction) (nearest town)

WELL PURPOSE: home
 (home, irrigation, municipal, industrial)

- WELL COMPLETION DATA:
- (1) diameter (inches) 2"
 - (2) total depth (feet) 23'
 - (3) static water level (feet) 7 below above top of ground.
 - (4) casing PVC, 19'
 (material) (depth)
2" if telescope see back.
 (size)
 - (5) screen 4', 19'
 (length) (depth to top)
1/4", galv S.S.
 (size) (material)
 - (6) pump 1/2, 10
 (HP) (yield gpm)
elec
 (type power)
 - (7) electric log no
 (yes or no)
- (organization running log)

(8) how well bottom plugged
1/2 inch weak valve

DRILLERS REMARKS:

MISS. Board of Water Comm.


8

FEB 8 1979

RECEIVED

If well telescopes please sketch and show depths.

GROUND LEVEL

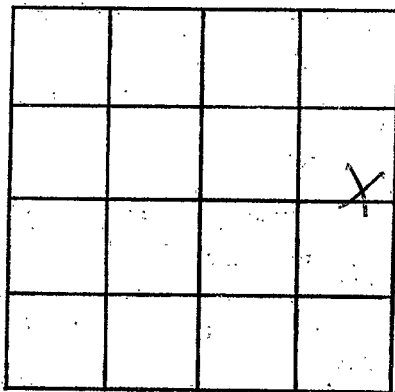

SECTION 30

Please indicate well location X.

ADDITIONAL INFORMATION

If more than one screen,
show locations of each on sketch.