

WAYNE

U 2030

6-11-81

MISSISSIPPI BOARD OF WATER COMMISSIONERS 416 North State Street Jackson, Mississippi 39201

4

WATER WELL DRILLERS LOG

6/11 1981 date well completed

CARB'S WELLSER firm name

WAYNE county well located

LANDOWNER: CLIFFORD SMITH

RT. 1 BOCKATONNA

MISS. 39932 (mailing address)

WELL LOCATION:

sec. 15 T-7 N R-5 E S (W)

4 miles EAST of BOCK. (distance) (direction) (nearest town)

WELL PURPOSE: CHICKEN HOUSE (home, irrigation, municipal, industrial)

WELL COMPLETION DATA:

- (1) diameter (inches) 2"
(2) total depth (feet) 60'
(3) static water level (feet) 34 below top of ground.

(4) casing 2" 50' (material) (depth)

(size) if telescope see back.

(5) screen 10' 50' (length) (depth to top)

2" P.V.C. (size) (material)

(6) pump 1 12 (HP) (yield gpm)

ELEC (type power)

(7) electric log (yes or no)

(organization running log)

(8) how well bottom plugged 2" CAP.

Table with 3 columns: description of formations encountered, from, to. Rows include RED CLAY, COURSE W. SD., W. VEL. CLAY, COURSE W. SD.

DEPT. OF NATURAL RESOURCES BUREAU OF LAND & WATER RESOURCES


JUN 15 1981

RECEIVED

DRILLERS REMARKS:

If well telescopes please sketch and show depths.

GROUND LEVEL

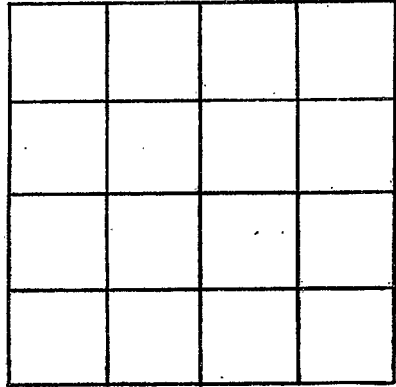

SECTION \_\_\_\_\_

Please indicate well location X.

ADDITIONAL INFORMATION

If more than one screen, show locations of each on sketch.