

MISSISSIPPI DEPARTMENT OF NATURAL RESOURCES
Bureau of Land and Water Resources
 Southport Mall
 P.O. Box 10631
 Jackson, Mississippi 39209
WATER WELL DRILLERS LOG

Wayne
U 2037
6-24-81

June 24 1981 Porter Drilling & Log Wayne
 date well completed firm name county well located

LANDOWNER: Wayne Carpenter
Box 140 A

Buckatunga Miss
 (mailing address)

WELL LOCATION:
 sec. 21 T. 70 N. R. 5 E. S. W
2 miles NE of Buckatunga
 (distance) (direction) (nearest town)

WELL PURPOSE: home
 (home, irrigation, municipal, industrial)

WELL COMPLETION DATA:

- (1) diameter (inches) 2"
- (2) total depth (feet) 74'
- (3) static water level (feet) 54' below above top of ground.
- (4) casing P.V.C. 69'
 (material) (depth)
2" if telescope see back.
 (size)
- (5) screen 5' 69'
 (length) (depth to top)
2" 8 slot P.V.C.
 (size) (material)
- (6) pump 1 12
 (HP) (yield gpm)
also
 (type power)
- (7) electric log no
 (yes or no)
 (organization running log)
- (8) how well bottom plugged 2" sand shell

description of formations encountered	from	to
clay	0	20
sand & clay	20	33
clay	33	44
sand	44	57
sand & clay	57	60
sand some clay	60	74
clay	74	92
coarse red sand	92	92
clay	92	105

62' 1" P.V.C. casing pipe

DEPT. OF NATURAL RESOURCES
 BUREAU OF LAND & WATER RESOURCES


JUL 22 1981

RECEIVED

DRILLERS REMARKS:
shell tray above screen

If well telescopes please sketch and show depths.

GROUND LEVEL

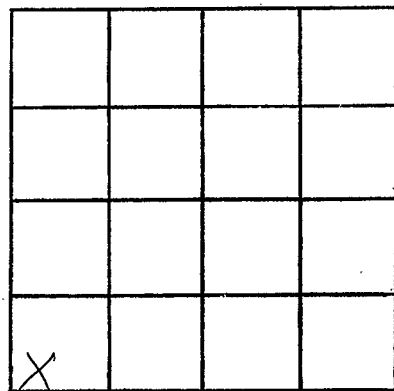

SECTION 21

Please indicate well location X.

ADDITIONAL INFORMATION

If more than one screen, show locations of each on sketch.