

Wayne  
U 2038  
7-24-81

MISSISSIPPI  
BOARD OF WATER COMMISSIONERS  
416 North State Street  
Jackson, Mississippi 39201


WATER WELL DRILLERS LOG

7/24 1981 CARR'S WELL SER WAYNE  
date well completed firm name county well located

LANDOWNER: <u>BUSTER McNISS</u>	description of formations encountered	from	to
<u>BUCKATUNNA,</u>	<u>TOP SOIL</u>	<u>6</u>	<u>7</u>
<u>MS. 39322</u>	<u>YELLOW SP.</u>	<u>7</u>	<u>9</u>
(mailing address)	<u>MED " "</u>	<u>9</u>	<u>15</u>
WELL LOCATION:	<u>COARSE " "</u>	<u>15</u>	<u>22</u>
sec <u>30 T 7 N</u>	<u>PER GRAVEL</u>	<u>22</u>	<u>37</u>
R <u>5 E</u>	<u>MED. WH. "</u>	<u>37</u>	<u>39</u>
in <u>1 N</u> miles	<u>STOPPED IN</u>		
(distance) (direction) of <u>Buck.</u>	<u>SAME</u>		
(nearest town)			
WELL PURPOSE:			
<u>(hom)</u> , Irrigation, municipal, industrial			
WELL COMPLETION DATA:			
(1) diameter (inches) <u>2"</u>			
(2) total depth (feet) <u>36'</u>			
(3) static water level (feet) <u>14</u> <u>below</u> <u>above</u>			
(4) casing <u>PVC</u> <u>31'</u>			
(material) (depth)			
<u>2"</u> if telescope see back.			
(5) screen <u>5'</u> <u>31'</u>			
(length) (depth to top)			
(6) pump <u>2"</u> <u>P.V.C.</u>			
(size) (material)			
(7) pump <u>1/2</u> <u>80</u>			
(HP) (yield gpm)			
<u>ELEC.</u>			
(type power)			
(8) electric log (yes or no)			
(organization running log)			
(8) how well bottom plugged <u>CAPPED</u>			
DRILLERS REMARKS:			

If well telescopes please sketch and show depths.

GROUND LEVEL

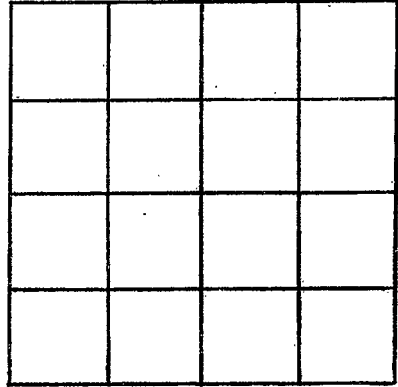

SECTION \_\_\_\_\_

Please indicate well location X.

ADDITIONAL INFORMATION

If more than one screen, show locations of each on sketch.