

MISSISSIPPI DEPARTMENT OF NATURAL RESOURCES
Bureau of Land and Water Resources
 Southport Mall
 P.O. Box 10631
 Jackson, Mississippi 39209
WATER WELL DRILLERS LOG

Wayne
U
2044

Oct 24 1993 Porter Drilling Co Wayne
 date well completed firm name county well located

LANDOWNER: <u>Larry Singler</u> <u>211 Buckatanna</u>	description of formations encountered	from	to
(mailing address)	clay	0	9
WELL LOCATION:	sandy	9	32
sec. <u>4</u> T. <u>7</u> N. R. <u>5</u> E. S. <u>5</u> miles <u>NE</u> of <u>Buckatanna</u> (distance) (direction) (nearest town)	clay	32	86
WELL PURPOSE: <u>home</u> (home, irrigation, municipal, industrial)	shale rock		86
WELL COMPLETION DATA:	sand & clay	86	93
(1) diameter (inches) <u>2"</u>	sand & clay	93	98
(2) total depth (feet) <u>98'</u>	stayed on clay		
(3) static water level (feet) <u>57'</u> below top of ground.			
(4) casing <u>P.V.C.</u> <u>93'</u> (material) (depth) <u>2"</u> (size) if telescope see back.			
(5) screen <u>5'</u> <u>93'</u> (length) (depth to top)			
(6) pump <u>1</u> <u>10</u> (HP) (yield gpm) <u>elec.</u> (type power)			
(7) electric log <u>no</u> (yes or no)			
(organization running log)			
(8) how well bottom plugged <u>2' sand bank</u>			
DRILLERS REMARKS:			

72' 1" P.V.C. deep pipe


DEPT. OF NATURAL RESOURCES
 BUREAU OF LAND & WATER RESOURCES

OCT 16 1993

RECEIVED

If well telescopes please sketch and show depths.

GROUND LEVEL

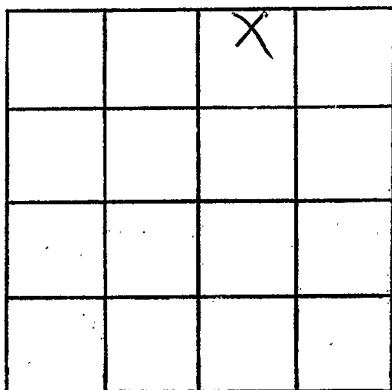

SECTION 4

Please indicate well location X.

ADDITIONAL INFORMATION

If more than one screen,
show locations of each on sketch.