

**MISSISSIPPI DEPARTMENT OF NATURAL RESOURCES**  
**Bureau of Land and Water Resources**  
 Southport Mall  
 P.O. Box 10631  
 Jackson, Mississippi 39209  
**WATER WELL DRILLERS LOG**

Wayne  
W  
2042

8/25 1984 BARR'S WELL SER WAYNE  
 date well completed firm name county well located

LANDOWNER: SANDRA CLEMENTS, RT. 1  
BUCKATUNNA, MS. 39322  
 (mailing address)

WELL LOCATION:  
 sec. 5 T 7 N S R 5 E W  
3 miles W of PROGRES  
 (distance) (direction) (nearest town)

WELL PURPOSE:  
 (home) irrigation, municipal, industrial

WELL COMPLETION DATA:  
 (1) diameter (inches) 2'  
 (2) total depth (feet) 135  
 (3) static water level (feet) 84  below above top of ground.  
 (4) casing P.V.C. 130'  
 (material) (depth)  
2" if telescope see back.  
 (size)  
 (5) screen 5' 130'  
 (length) (depth to top)  
2" P.V.C.  
 (size) (material)  
 (6) pump 1 8  
 (HP) (yield gpm)  
FLEC.  
 (type power)  
 (7) electric log NO  
 (yes or no)  
 (organization running log)  
 (8) how well bottom plugged CAPPED


description of formations encountered	from	to
TOP SOIL	0	2
1. PK. WH. CLAY	7	25
BRN YEL "	25	30
PK. "	30	31
RR. PK. ↓ WH. "	31	37
BR. ↓ YEL. "	37	41
RR. PK. ↓ WH. "	41	50
BLU. "	50	110
1. WH. SD.	110	117
MED. WH. "	117	120
C. I. WH. "	120	135

DEPT. OF NATURAL RESOURCES  
 BUREAU OF LAND & WATER RESOURCES  
 SEP - 4 1984  
**RECEIVED**

DRILLERS REMARKS:

If well telescopes please sketch and show depths.

GROUND LEVEL

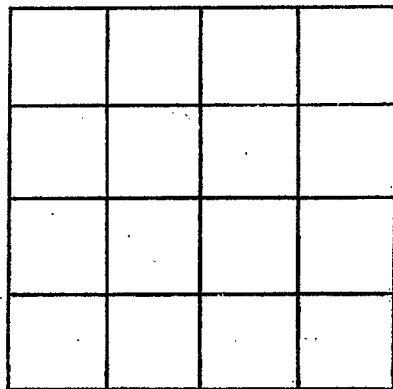

SECTION \_\_\_\_\_

Please indicate well location X.

ADDITIONAL INFORMATION

If more than one screen,  
show locations of each on sketch.