

MISSISSIPPI DEPARTMENT OF NATURAL RESOURCES

Bureau of Land and Water Resources

Southport Mall

P.O. Box 10631

Jackson, Mississippi 39209

WATER WELL DRILLERS LOG

WAYNE  
U  
2013

Oct 15 1985 *Robert D. Hall & Son* *Itasca*  
date well completed firm name county well located


LANDOWNER: *Cliff and Walter*  
*211 Ruckertown*  
(mailing address)

WELL LOCATION:  
sec *23* T *7* N R *5* E  
*2 1/2* miles *SE* of *Bandana*  
(distance) (direction) (nearest town)

WELL PURPOSE: *Water for house*  
(home, irrigation, municipal, industrial)

WELL COMPLETION DATA:  
(1) diameter (inches) *4"*  
(2) total depth (feet) *163*  
(3) static water level (feet) *99* *below* *above*  
top of ground.  
(4) casing *PVC* *153*  
(material) (depth)  
*4"* if telescope see back.  
(size)  
(5) screen *10'* *153*  
(length) (depth to top)  
*2"* *Galv. S.S.*  
(size) (material)  
(6) pump *1.2* *1.2*  
(HP) (yield gpm)  
*elec*  
(type power)  
(7) electric log *no*  
(yes or no)  
(organization running log)  
(8) how well bottom plugged *no*

description of formations encountered	from	to
<i>thin sand</i>	<i>0</i>	<i>21</i>
<i>thin sand</i>		<i>21</i>
<i>clay</i>	<i>81</i>	<i>125</i>
<i>sand</i>	<i>125</i>	<i>160</i>
<i>sand some clay</i>	<i>160</i>	<i>165</i>
<i>sand</i>	<i>165</i>	<i>175</i>
<i>140' 1" #90 PVC casing</i>		<i>175</i>

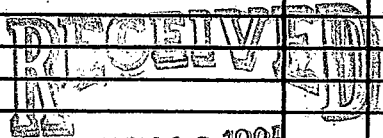


NOV 22 1985

DRILLERS REMARKS:

Department of Natural Resources  
Bureau of Land & Water Resources

If well telescopes please sketch and show depths.

GROUND LEVEL

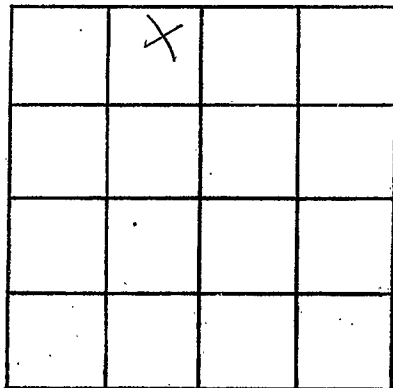

SECTION 33

Please indicate well location X.

ADDITIONAL INFORMATION

If more than one screen,  
show locations of each on sketch.