

WAYNE

U 2053

5-28-81

MISSISSIPPI BOARD OF WATER COMMISSIONERS
416 North State Street
Jackson, Mississippi 39201

WATER WELL DRILLERS LOG

5/28

1981

CARD'S WELL SER

WAYNE

date well completed

firm name

county well located

LANDOWNER: CLYDE REUETTE

BUCKATONNA, MS.

39322

(mailing address)

WELL LOCATION:

sec. 30 T. 7 N S

R. 5 E W

miles 1 N BUCKATONNA (distance) (direction) (nearest town)

WELL PURPOSE:

(home, irrigation, municipal, industrial)

WELL COMPLETION DATA:

- (1) diameter (inches) 2"
- (2) total depth (feet) 36
- (3) static water level (feet) 13 below top of ground.
- (4) casing P.V.C. 31 (material) (depth)

(size) If telescope see back.

- (5) screen 5' 31' (length) (depth to top)

2" P.V.C. (size) (material)

- (6) pump 1 100 (HP) (yield gpm)

ELEC (type power)

- (7) electric log NO (yes or no)

(organization running log)

- (8) how well bottom plugged 2" CAP.

description of formations encountered

from to

TOP SOIL	0	2
VEL CLAY	2	10
V.V.W. "	10	16
W. SAND	16	25
PER GRAVEL	25	35
COURSE W. SD. "	35	36
W. PER GRAVEL		

DEPT. OF NATURAL RESOURCES
BUREAU OF LAND & WATER RESOURCES


JUN 15 1981

DRILLERS REMARKS:

RECEIVED

If well telescopes please sketch and show depths.

GROUND LEVEL

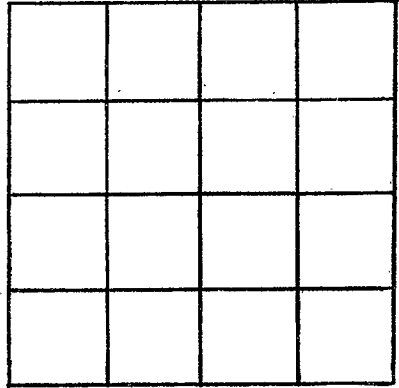

SECTION _____

Please indicate well location X.

ADDITIONAL INFORMATION

If more than one screen,
show locations of each on sketch.