

MISSISSIPPI DEPARTMENT OF ENVIRONMENTAL QUALITY

Office of Land and Water Resources

P. O. Box 10631
Jackson, MS. 39289-0631
WATER WELL DRILLERS LOG

COUNTY WELL LOCATED Wayne	
WELL NUMBER U-2056	CODED
DATE WELL COMPLETED 6-19-00	

PERMIT NUMBER
NAME OF DRILLING FIRM Thompson Bros.

NAME & MAILING ADDRESS OF LANDOWNER Greg Revette			
Hwy 45 Bucatunna MS.			
WELL LOCATION	SEC 19	TOWNSHIP 7 S	RANGE 5 E
DISTANCE 1 Miles	DIRECTION N	NEAREST TOWN Bucatunna	
OTHER LANDMARK			
WELL PURPOSE: Home, Irrigation, Municipal, Industrial, Fish Pond, etc. chicken farm			

PUMP DATA			
PUMP TYPE (Circle One): <input checked="" type="radio"/> Submersible, <input type="radio"/> Turbine, <input type="radio"/> Jet <input type="radio"/> Flowing Well, <input type="radio"/> Other (Describe)			
POWER TYPE (Circle One): Electric, <input type="radio"/> Tractor, <input type="radio"/> Diesel, <input type="radio"/> Gasoline, <input type="radio"/> Butane, Other (Describe) H/P 1 1/2			
Pump Capacity (GPM) 27	No. of Stages	Setting Depth 60 FT.	
PUMP TEST			
Well yielded 100 GPM with a drawdown of 40 ft. after air lift hours of pumping			

WELL DATA		
Well Depth 105	Casing Diameter (In.) 4	Casing Length (Ft.) 95
Type of Casing PVC	Hole Depth 105	Depth to Static Water Level 20

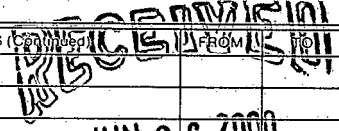
LOG DATA	
TYPE OF LOG RUN (Circle One): <input type="radio"/> No Log Run, <input type="radio"/> Electric, <input type="radio"/> Gamma-Ray, <input type="radio"/> Density, <input type="radio"/> Sonic, <input type="radio"/> Neutron, <input type="radio"/> Other (Describe)	
Name of Organization Running Log	

TYPE OF COMPLETION: (Circle One or More): <input checked="" type="radio"/> Gravel Packed, <input type="radio"/> Underreamed, <input type="radio"/> Telescoped, <input type="radio"/> Natural Development, <input type="radio"/> Open Hole, <input type="radio"/> Other (Describe)	
WELL GROUTED TO A DEPTH OF 10 FEET Type Grout (circle one): Cement, Bentonite, or Mix	

GEOLOGIC DATA (Office Use Only)			
Surface Elev.	Geologic Unit	Unit Thickness	Depth to Top
Subs. SWL	Date	Analysis	Aquifer Test

SCREEN DATA		
Diameter - Inches 4	Length - Feet 10	Slot Size - inches .06
Screen Type PVC Wrap	Depth to Bottom - Feet 105	

Driller's Remarks

DESCRIPTION OF FORMATIONS ENCOUNTERED	FROM	TO	FORMATIONS (Continued)
red clay	0	10	<div style="text-align: center;">  <p>JUN 26 2000</p> <p>Dept. of Environmental Quality Office of Land & Water Resources</p> </div>
sand	10	50	
white clay	50	75	
sand	75	105	

IF MORE SPACE IS NEEDED, USE BACK

If well telescopes please
sketch and show depths.

GROUND LEVEL

SECTION _____

Please indicate well location X.

ADDITIONAL INFORMATION

If more than one screen,
show location of each on sketch.