

Wayne
 V4
 6-67

MISSISSIPPI
 BOARD OF WATER COMMISSIONERS
 416 North State Street
 Jackson, Mississippi 39201

WATER WELL DRILLERS LOG

June 15, 1967 date well completed
 Barton Drilling & Pump firm name
 Wayne county well located

LANDOWNER: Cecil Malone
 At 2 Bilton, Miss (mailing address)
 WELL LOCATION:
 sec 23 T 6 N R 9 E
 15 miles SW of Clara (distance) (direction) (nearest town)

description of formations encountered	from	to
red chalk	0	10
blue chalk	10	72
fine blue sand & some chalk	72	82
fine blue sand	82	93
stopped on chalk		

WELL PURPOSE: home (home, irrigation, municipal, industrial)

screen inserted 3' into casing


- WELL COMPLETION DATA:
- (1) diameter (inches) 2'
 - (2) total depth (feet) 93'
 - (3) static water level (feet) 49' below top of ground
 - (4) casing steel (material), 84' (depth)
 2' if telescope see back.
 - (5) screen 12' (length), 81' (depth to top)
 90 ga 1/4" brass jacket (size) (material)
 - (6) pump 3/4 (HP), 7 (yield gpm)
 elec (type power)
 - (7) electric log no (yes or no)
 (organization running log)
 - (8) how well bottom plugged flush screen



DRILLERS REMARKS:

If well telescopes please sketch and show depths.

GROUND LEVEL

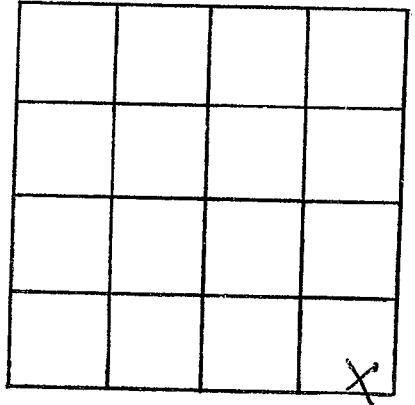

SECTION 23

Please indicate well location X.

ADDITIONAL INFORMATION

If more than one screen,
show locations of each on sketch.