

Wayne
V5
10-66

MISSISSIPPI BOARD OF WATER COMMISSIONERS

WATER WELL DRILLERS LOG

Date: Oct 14, 1966, Driller: Port Drilling Co. County: Wayne
(Name)

(1) Owner of Land: G. B. Nicolson
(Name)
Box 2 Dickson, Miss
(Address)

(2) Location: NW 1/4, SW 1/4, Sec. 24 T6 R9
19 miles SW of Waynesboro
(distance) (direction) (Nearest Town)

(3) Topography: Hilly
(Hilly) (Flat) (Level)

(4) Purpose of Well: domestic
(Domestic Irrigation
Municipal, Industrial, Other)

Description & Color of Materials Sand, Clay, Red Clay, Shell, etc.	Thick- ness Feet	Depth Feet
<u>red clay & chert</u>	<u>20</u>	<u>20</u>
<u>blue chalk</u>	<u>52</u>	<u>72</u>
<u>blue sand</u>	<u>10</u>	<u>82</u>
<u>sand & a little chert</u>	<u>1</u>	<u>83</u>
<u>stopped while still in sand</u>		

Information upon completion of well:

(1) Diameter 2" inches.

(2) Total Depth 83' feet.

(3) Water Level 58' feet below top of ground.

(4) Cased to 77', Size 2"


(5) Screen: Size 1 1/4", Length 5'

(6) Were any formations sealed against pollution?
yes, X no.

If YES depth of formation _____

Why _____

Drillers Remarks: _____

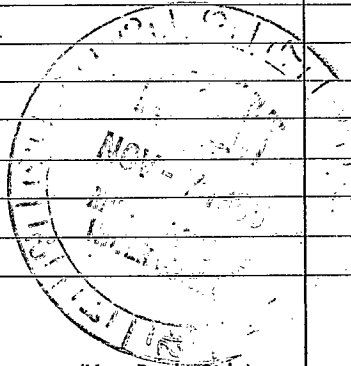

(Use Back Side)

Well No.

