

Wayne
V6
6-67

MISSISSIPPI
BOARD OF WATER COMMISSIONERS
416 North State Street
Jackson, Mississippi 39201

WATER WELL DRILLERS LOG

June 28 1967 Porter Drilling & Supply Wayne
date well completed firm name county well located

LANDOWNER: Daniel Ray Brewer

description of formations encountered	from	to
<u>red clay</u>	<u>0</u>	<u>6</u>
<u>white chalk</u>	<u>6</u>	<u>70</u>
<u>soft fine sand & chalk</u>	<u>70</u>	<u>83</u>
<u>slight on hard chalk</u>		

Rt 2 Richton Miss
(mailing address)


WELL LOCATION:
sec 34 T 6 (N) R 9 (E) W
17 miles SW of Clara
(distance) (direction) (nearest town)

WELL PURPOSE: home
(home, irrigation, municipal, industrial)

- WELL COMPLETION DATA:
- (1) diameter (inches) 2"
 - (2) total depth (feet) 93'
 - (3) static water level (feet) 45 below above top of ground.
 - (4) casing steel, 76,
(material) (depth)
2' if telescope see back.
(size)
 - (5) screen 6'80 ga, 77
(length) (depth to top)
1/4", bronze jacket
(size) (material)
 - (6) pump 3/4 5
(HP) (yield gpm)
elec
(type power)
 - (7) electric log no
(yes or no)


(organization running log)
 - (8) how well bottom plugged flush screen

DRILLERS REMARKS:

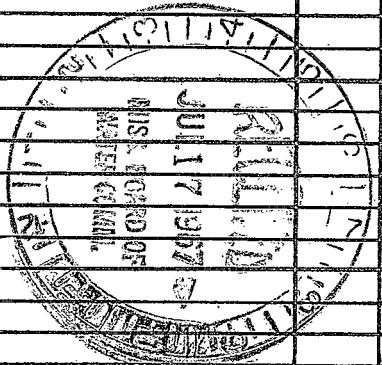

If well telescopes please sketch and show depths.

GROUND LEVEL

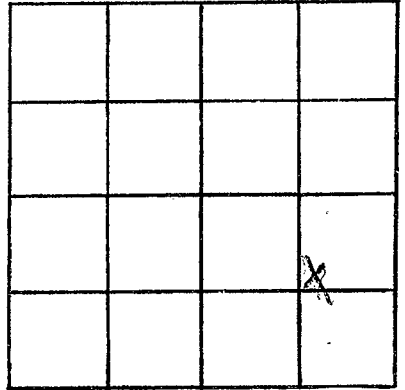

SECTION 34

Please indicate well location X.

ADDITIONAL INFORMATION

If more than one screen, show locations of each on sketch.