

Wayne
V8
10-18-68

MISSISSIPPI
BOARD OF WATER COMMISSIONERS
416 North State Street
Jackson, Mississippi 39201

INDEX

WATER WELL DRILLERS LOG

Oct 18 1968 date well completed
R. B. Roubt Drilling & Log firm name
Wayne county well located

LANDOWNER: Tilford
Alumbank
At 2 Brighton mine
(mailing address)

description of formations encountered	from	to
red clay	0	9
chalk	9	20
sand	20	26
white chalk	26	30
fine sand & chalk	30	72
strat on hard chalk		

WELL LOCATION:
sec 35 T 6 N R 9 E
15 miles SW of Clam
(distance) (direction) (nearest town)

WELL PURPOSE: home
(home, irrigation, municipal, industrial)

WELL COMPLETION DATA:
(1) diameter (inches) 2"
(2) total depth (feet) 72
(3) static water level (feet) 58 ^{below} _{above} top of ground.
(4) casing steel 34
(material) (depth)
2" If telescope see back.
(size)
(5) screen 9' 83'
(length) (depth to top)
1/4 30 ga brass packer
(size) (material)
(6) pump 1 7 1/2
(HP) (yield gpm)
elec
(type power)
(7) electric log no
(yes or no)
(organization running log)

INDEX

NOV 7 1968


MISS. DE. OF
WATER COMM.

(8) how well bottom plugged
black point

DRILLERS REMARKS:

If well telescopes please sketch and show depths.

GROUND LEVEL

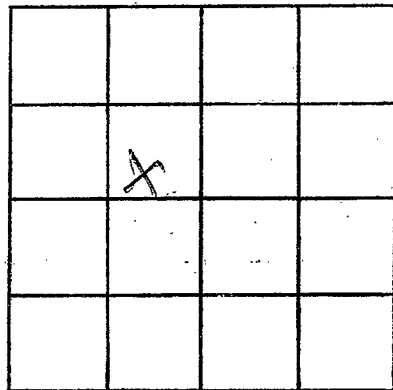

SECTION 35

Please indicate well location X.

ADDITIONAL INFORMATION

If more than one screen, show locations of each on sketch.