

Wayne  
 V 10  
 4-1-70

MISSISSIPPI  
 BOARD OF WATER COMMISSIONERS  
 416 North State Street  
 Jackson, Mississippi 39201

CODED

WATER WELL DRILLERS LOG

April 1 1970 Porter Drilling & Log Wayne  
 date well completed firm name county well located

LANDOWNER: Telford  
Alumbaugh  
 Rt 2 Dickton Miss  
 (mailing address)

description of formations encountered	from	to
red clay	0	14
white chalk	14	79
fine sand & chalk	79	91
stopped on chalk		

WELL LOCATION:  
 sec 34 T 60 N R 9 E  
14 miles SW of Clary  
 (distance) (direction) (nearest town)

WELL PURPOSE: none  
 (home, irrigation, municipal, industrial)

- WELL COMPLETION DATA:
- diameter (inches) 2"
  - total depth (feet) 91'
  - static water level (feet) 54 below above top of ground.
  - casing steel 82 1/2'  
 (material) (depth)  
2" if telescope see back.  
 (size)
  - screen 9' 92'  
 (length) (depth to top)  
1 1/4" 80 ga brass jacket  
 (size) (material)
  - pump 1 8  
 (HP) (yield gpm)  
elec  
 (type power)
  - electric log no  
 (yes or no)

7 1/4" 80 ga brass jacket  
test in with peacher

CODED

(organization running log)

(8) how well bottom plugged  
flush point


APR 17 1970

DRILLERS REMARKS:

MISS. BD. OF  
 WATER COMM.

If well telescopes please sketch and show depths.

GROUND LEVEL

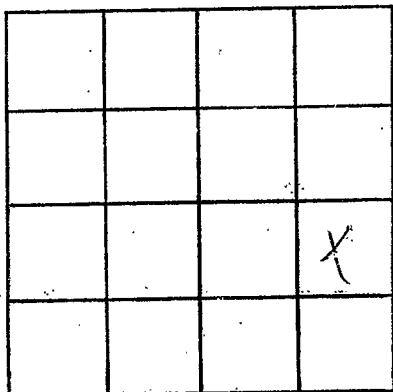

SECTION 34

Please indicate well location X.

ADDITIONAL INFORMATION

If more than one screen,  
show locations of each on sketch.