

Wayne
VII
6-25-70

MISSISSIPPI
BOARD OF WATER COMMISSIONERS
416 North State Street
Jackson, Mississippi 39201

CODED

WATER WELL DRILLERS LOG

June 25 1970 Porter-Drilling & Log Wayne
date well completed firm name county well located

LANDOWNER: St. E. Nickleson
Box 2, Dickton, Miss
(mailing address)

WELL LOCATION:
sec. 13 T 6 N R. 9 E
10 miles S.W of Clava
(distance) (direction) (nearest town)

WELL PURPOSE: home
(home, irrigation, municipal, industrial)

- WELL COMPLETION DATA:
- (1) diameter (inches) 2"
 - (2) total depth (feet) 295
 - (3) static water level (feet) 86 below top of ground.
 - (4) casing steel 280'
(material) (depth)
2" (size) if telescope see back.
 - (5) screen 12' 283'
(length) (depth to top)
1 1/4" 80 ga S.S.
(size) (material)
 - (6) pump 1/2 hp 3 1/2
(HP) (yield gpm)
elec
(type power)
 - (7) electric log no
(yes or no)

(organization running log)

(8) how well bottom plugged
flush cement

DRILLERS REMARKS:

description of formations encountered	from	to
red clay	0	5
red chapt	5	28
blue chalk	28	33
med. dirty sand ch	33	45
blue chalk	45	62
fine sand	62	65
blue chalk	65	90
fine sand & chalk	90	97
blue chalk	97	207
fine powder sand	207	221
blue chalk	221	244
fine sand & chalk	244	283
red sand	283	295
stayed while still in sand		

cyl. set at 105'
4' 1 1/4" log pipe on top
of 12' 80 ga S.S. screen
bottom with packer


CODED

7 1970

MISSISSIPPI BOARD OF WATER COMMISSIONERS

If well telescopes please sketch and show depths.

GROUND LEVEL

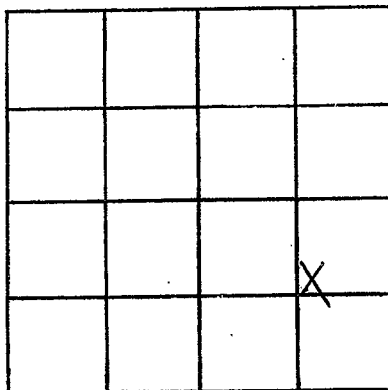

SECTION 13

Please indicate well location X.

ADDITIONAL INFORMATION

If more than one screen,
show locations of each on sketch.