

MISSISSIPPI
BOARD OF WATER COMMISSIONERS
416 North State Street
Jackson, Mississippi 39201

CODED

WATER WELL DRILLERS LOG

WAYNE
V 12
12-14-70

Dec 14 1970 Roy Westwater wells Wayne
date well completed firm name county well located

LANDOWNER:	Description of formations encountered	from	to
Sherron Brewer			
Rt 2	Sandy clay	0	5
Richston Miss	Clay	5	80
(mailing address)	Sand	80	90

WELL LOCATION:
sec. 38 T 2 N R 9 E
1.4 miles E of Crutch Miss
(distance) (direction) (nearest town)

WELL PURPOSE: home
(home, irrigation, municipal, industrial)

- WELL COMPLETION DATA:
- (1) diameter (inches) 2 in
 - (2) total depth (feet) 90
 - (3) static water level (feet) 60 below above top of ground.
 - (4) casing galv. 85
(material) (depth)
 - (size) if telescope see back.
 - (5) screen 5 85
(length) (depth to top)
 - 1/4 St steel
(size) (material)
 - (6) pump 1/2 3
(HP) (yield gpm)
 - Rea
(type power)
 - (7) electric log No
(yes or no)
 - (organization running log)
 - (8) how well bottom plugged Washwell

CODED


DEC 17 1970

DRILLERS REMARKS:

MISS. BD. OF
WATER COM.

If well telescopes please sketch and show depths.

GROUND LEVEL

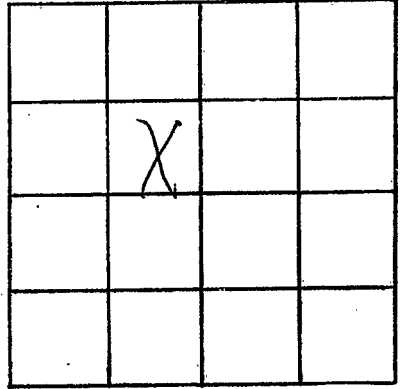

SECTION 35

Please indicate well location X.

ADDITIONAL INFORMATION

If more than one screen,
show locations of each on sketch.