

WAYNE

V 13

6-26-71

MISSISSIPPI BOARD OF WATER COMMISSIONERS 416 North State Street Jackson, Mississippi 39201

CODED

WATER WELL DRILLERS LOG

June 26 1971 date well completed

21 Port Drilling & Supply firm name

Wayne county well located

LANDOWNER: James Long

description of formations encountered

from

to

212 Brighton Mine (mailing address)

Chalk	0	30
sand. chalk	30	45
Chalk	45	80
lime sand	80	84
Chalk	84	86
rest sand from	86	96
slip on chalk		

WELL LOCATION:

sec 24 T 60 N R 9 E 11 miles SW of Clary (nearest town)

WELL PURPOSE: home (home, irrigation, municipal, industrial)

10' 1 1/2" 90 gpm SS. separate on case with shell funnel above to backwash valve on end.

WELL COMPLETION DATA:

- (1) diameter (inches) 2"
- (2) total depth (feet) 96'
- (3) static water level (feet) 60' (below/above top of ground)
- (4) casing (material) steel 85 1/2' (depth) 2" (size) if telescope see back
- (5) screen (length) 10' (depth to top) 85 1/2' 1 1/4" (size) 80 gpm SS. (material)
- (6) pump (HP) 1 (yield gpm) 120 (type power) elec
- (7) electric log (yes or no) no (organization running log)

84' 1 1/4" drop pipe

CODED

(8) how well bottom plugged back wash valve


14.1971

DRILLERS REMARKS:

LOGS OF WATER COMMISSIONERS

If well telescopes please sketch and show depths.

GROUND LEVEL

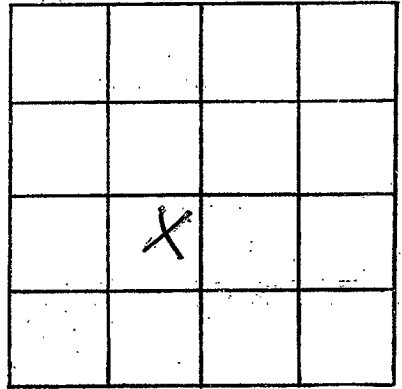

SECTION 24

Please indicate well location X.

ADDITIONAL INFORMATION

If more than one screen,
show locations of each on sketch.