

Wayne
V 15
12-31-71

MISSISSIPPI
BOARD OF WATER COMMISSIONERS
416 North State Street
Jackson, Mississippi 39201

CODED

WATER WELL DRILLERS LOG

Dec 31 1971 Porter Drilling & Supply Wayne
date well completed firm name county well located

LANDOWNER: Rayford Stevenson
42 Brighton Miss
(mailing address)

description of formations encountered	from	to
Clay	0	12
sand	12	18
blue Chalk	18	211
sand & chalk	211	246
fine sand	246	262
Chalk	262	271
sand & some chalk	271	282
course sand & some		
sea gravel	282	289
slotted white steel in sand		

WELL LOCATION:
sec. 36 T. 60 N. R. 9 E.
11 miles SW of Clara
(distance) (direction) (nearest town)

WELL PURPOSE: home
(home, irrigation, municipal, industrial)

- WELL COMPLETION DATA:
- (1) diameter (inches) 2"
 - (2) total depth (feet) 289'
 - (3) static water level (feet) 29' (below/above top of ground)
 - (4) casing steel 283'
(material) (depth)
2" if telescope see back.
(size)
 - (5) screen 4" 285'
(length) (depth to top)
1/4" slot S.S.
(size) (material)
 - (6) pump 1/2 8
(HP) (yield gpm)
elec.
(type power)
 - (7) electric log no
(yes or no)
 - (organization running log)
 - (8) how well bottom plugged
flush joint

42' 1" drop pipe
4' 1/4" slot S.S. with
3' 1/2" lap pipe thrust
in with packer


CODED

JAN 28 1972

DRILLERS REMARKS:

If well telescopes please sketch and show depths.

GROUND LEVEL

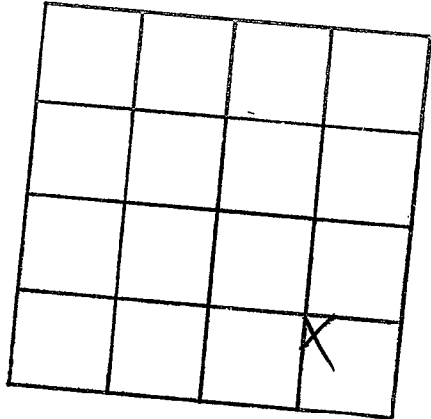

SECTION

36

Please indicate well location X.

ADDITIONAL INFORMATION

Lined area for additional information.

If more than one screen, show locations of each on sketch.