

WAYNE
V 16
12-71

MISSISSIPPI
BOARD OF WATER COMMISSIONERS
416 North State Street
Jackson, Mississippi 39201

CODED

WATER WELL DRILLERS LOG

1/16 1972 Loggie Well Service Wayne
date well completed firm name county well located

LANDOWNER: A. G. Ross

description of formations encountered from to

BJ # 3
Waynesboro, Miss
(mailing address)

Clay 0 60

WELL LOCATION:
sec. 31 T. 6N R. 9 E. W
10 miles SW of Clare
(distance) (direction) (nearest town)

Blue marl 60 150
fine sand 150 190
Gravel 190 220

WELL PURPOSE: Home
(home, irrigation, municipal, industrial)

WELL COMPLETION DATA:

- (1) diameter (inches) 4
- (2) total depth (feet) 226
- (3) static water level (feet) 147 below above top of ground
- (4) casing Gal 2 1/2
(material) (depth)
(size) If telescope see back.
- (5) screen 10 2 1/2
(length) (depth to top)
2 Steel
(size) (material)
- (6) pump 1 1/2 8
(HP) (yield gpm)
Elec
(type power)
- (7) electric log NO
(yes or no)
NO
(organization running log)
- (8) how well bottom plugged B. W.

CODED


FEB 28 1972

DRILLERS REMARKS:

MISS. BD. OF
WATER COMMISSIONERS
JACKSON, MISSISSIPPI

If well telescopes please sketch and show depths.

GROUND LEVEL

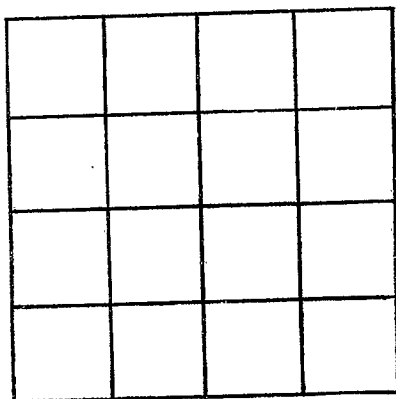

SECTION _____

Please indicate well location X.

ADDITIONAL INFORMATION

If more than one screen, show locations of each on sketch.