

WAYNE
 ✓ 19
 6-8-73

MISSISSIPPI
 BOARD OF WATER COMMISSIONERS
 416 North State Street
 Jackson, Mississippi 39201

CODED

WATER WELL DRILLERS LOG

6/8 1973 Cards well Sewer Wayne
 date well completed firm name county well located


LANDOWNER: <u>K. C. Sanders</u>	description of formations encountered	from	to
<u>RD 2 Richton, Miss</u>	Top soil	0	1
	Red Clay	1	5
	Red & white clay	5	8
	white clay	8	15
(mailing address)	yellow & gray clay	15	20
WELL LOCATION:	white limy clay	20	34
sec <u>13</u> T <u>6N</u> R <u>7E</u>	Blue clay	34	45
S <u>W</u> W <u>SW</u> of <u>CLARK</u>	Blue sticky MARL	45	55
10 miles (distance) (direction) (nearest town)	GRAYISH ROCK	55	56
WELL PURPOSE: <u>Home</u>	Blue MARL	56	64
(home, irrigation, municipal, industrial)	Bluish Rock	64	65
WELL COMPLETION DATA:	Soft Blue MARL	65	76
(1) diameter (inches) <u>4 5/8 X 2</u>	Fine fine white sand	76	88
(2) total depth (feet) <u>210</u>	GRAYISH CLAY	88	90
(3) static water level (feet) <u>60</u> below above top of ground.	Fine white sand	90	94
(4) casing <u>PVC, 200'</u> (material) (depth)	Blue clay	94	174
(size) if telescope see back.	BROKEN GRAY clay & sand	174	178
(5) screen <u>10'</u> (length) <u>200'</u> (depth to top)	Fine white sand	178	192
<u>2"</u> (size) <u>PVC</u> (material)	Med white sand	192	196
(6) pump <u>1</u> (HP) <u>6</u> (yield gpm)	COURSE white sand	196	199
<u>clock</u> (type power)	PEA GRAVEL	199	204
(7) electric log <u>NO</u> (yes or no)	COURSE white sand	204	210
(organization running log)			
(8) how well bottom plugged <u>2" R.W.V.</u>			
DRILLERS REMARKS: <u>still in sand when quit tested @ 10:19 PM</u>			

CODED

JUN 11 1973

If well telescopes please sketch and show depths.

GROUND LEVEL

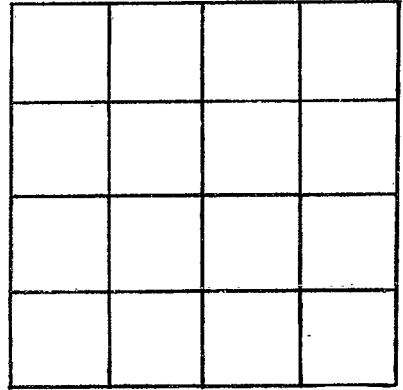

SECTION _____

Please indicate well location X.

ADDITIONAL INFORMATION

If more than one screen, show locations of each on sketch.