

**MISSISSIPPI
BOARD OF WATER COMMISSIONERS**
416 North State Street
Jackson, Mississippi 39201

SEP 12 1973

WAYNE
V 20
8-2-73

WATER WELL DRILLERS LOG

CODED

MISS. BD. OF
WATER COMM.

Aug 2 1973 date well completed 23 Barber Drilling & Supply firm name Wayne county well located

LANDOWNER: Clarence Brewer

description of formations encountered

from to

212 Dickton Miss
(mailing address)

sandy clay	0	25
smooth	25	33
white cherts	33	84
fine sand some cherts	84	91
stayed on cherts		

WELL LOCATION:

sec 26 T 6 (N) R 9 E
S W
11 miles S.W. of Clava
(distance) (direction) (nearest town)

5' 1/4" 6" sl. ss with
6" nipple on bottom
3.3' 1/2" lay pipe
stuck in with 1/2" anchor

WELL PURPOSE: domestic
(home, irrigation, municipal, industrial)

WELL COMPLETION DATA:

- (1) diameter (inches) 2"
- (2) total depth (feet) 91'
- (3) static water level (feet) 59' below above top of ground.
- (4) casing steel, 84'
(material) (depth)
2" if telescope see back.
(size)
- (5) screen 5', 25'
(length) (depth to top)
1 1/4", hole S.S.
(size) (material)
- (6) pump 1, 6
(HP) (yield gpm)
elec.
(type power)
- (7) electric log no
(yes or no)

CODED


(organization running log)

(8) how well bottom plugged

DRILLERS REMARKS:

If well telescopes please sketch and show depths.

GROUND LEVEL

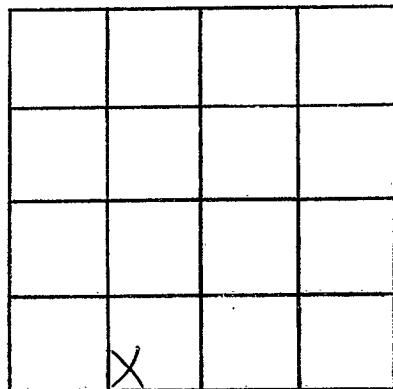

SECTION 26

Please indicate well location X.

ADDITIONAL INFORMATION

If more than one screen,
show locations of each on sketch.