

WAYNE  
V21  
6-5-74

MISSISSIPPI  
BOARD OF WATER COMMISSIONERS  
416 North State Street  
Jackson, Mississippi 39201

CODED

WATER WELL DRILLERS LOG

June 5 1974 Roy West Water Wells Wayne  
date well completed firm name county well located

LANDOWNER: Harwood Shipp

description of formations encountered	from	to
Clay	0	6
sandy clay	6	25
clay	25	85
sand	85	95
Blue clay	95	195
sand	195	220

Rt 2  
Richston miss  
(mailing address)

WELL LOCATION:

sec 24 T 6 N R 9 E  
S  
11 miles W of Richston  
(distance) (direction) (nearest town)

WELL PURPOSE: home  
(home, irrigation, municipal, industrial)

CODED

WELL COMPLETION DATA:

- (1) diameter (inches) 2
- (2) total depth (feet) 220
- (3) static water level (feet) 90 below above top of ground.
- (4) casing PVC, 215,  
(material) (depth)  
2 if telescope see back.  
(size)
- (5) screen 5 ft, 215  
(length) (depth to top)  
1/2, st steel  
(size) (material)
- (6) pump 1 10  
(HP) (yield gpm)  
P&A  
(type power)
- (7) electric log No  
(yes or no)
- (8) how well bottom plugged washed

RECEIVED  
MAY 15 1974


MAY 5 1974

MISS. BD. OF WATER COMMISSIONERS

DRILLERS REMARKS:

If well telescopes please sketch and show depths.

GROUND LEVEL

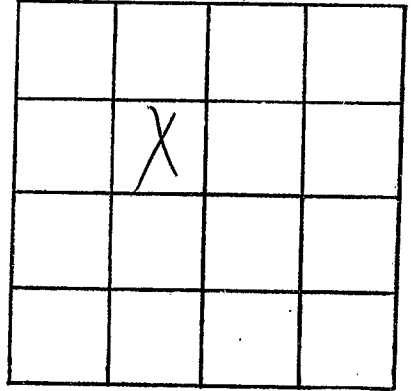

SECTION 24

Please indicate well location X.

ADDITIONAL INFORMATION

If more than one screen,  
show locations of each on sketch.