

WAYNE  
V 2001  
3-1-76

MISSISSIPPI  
BOARD OF WATER COMMISSIONERS  
416 North State Street  
Jackson, Mississippi 39201

WATER WELL DRILLERS LOG

March 1 1976 *Bob Drilling Log* *Itazoupa*  
date well completed firm name county well located

LANDOWNER: *Clarence Brewer*  
*At 2 Buckton Miss*  
(mailing address)

WELL LOCATION:  
sec. *34* T. *6* N. R. *9* E. S. *12*  
*12* miles S.W. of *Clava*  
(distance) (direction) (nearest town)

WELL PURPOSE: *none*  
(home, irrigation, municipal, industrial)

- WELL COMPLETION DATA:
- (1) diameter (inches) *2*
  - (2) total depth (feet) *92'*
  - (3) static water level (feet) *57* below top of ground.
  - (4) casing *P.V.C.* *84 1/2'*  
(material) (depth)  
*2'* if telescope see back.  
(size)
  - (5) screen *22'* *84 1/2'*  
(length) (depth to top)  
*1 1/2"* *hshd SS.*  
(size) (material)
  - (6) pump *1* *7 1/2*  
(HP) (yield gpm)  
*elec.*  
(type power)
  - (7) electric log *no*  
(yes or no)
- (organization running log)

description of formations encountered	from to	
<i>red clay &amp; sand</i>	<i>0</i>	<i>3.3</i>
<i>to clay</i>	<i>3.3</i>	<i>8.3</i>
<i>fine sand &amp; clay</i>	<i>8.3</i>	<i>29</i>
<i>clay</i>	<i>29</i>	<i>40</i>
<i>red sand &amp; clay</i>	<i>40</i>	<i>73</i>
<i>clay</i>	<i>73</i>	<i>92</i>
<i>8 1/2' 1" hshd SS.</i>		
<i>screwed on end of cas.</i>		
<i>with backwash valve</i>		
<i>on end of steel pipe</i>		
<i>above</i>		
<i>72' 1" P.V.C. pipe</i>		
<i>pipe</i>		

(8) how well bottom plugged  
*bad*


DRILLERS REMARKS:



APR 19 1976

If well telescopes please sketch and show depths.

GROUND LEVEL

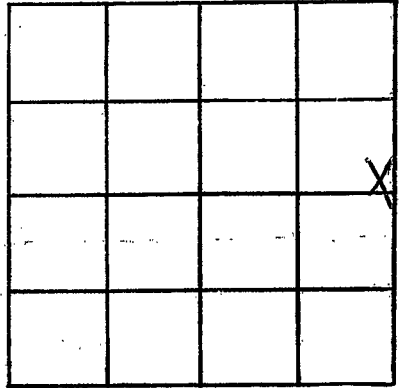

SECTION 34

Please indicate well location X.

ADDITIONAL INFORMATION

If more than one screen, show locations of each on sketch.