

WAYNE  
 V 2004  
 11-7-77

MISSISSIPPI  
 BOARD OF WATER COMMISSIONERS  
 416 North State Street  
 Jackson, Mississippi 39201

13¢

WATER WELL DRILLERS LOG

Nov 9

1977 WILWAIN WATER WELL SERVICE Wayne

date well completed

RT. from road 37

county well located

WAYNESBORO MISS 39267

LANDOWNER:

A. C. Waites  
 Waynesboro Miss  
 (mailing address)

description of formations encountered

from

to

Clay	0	27
Sand	27	30
Clay	30	45
Medium Blue Sand	45	63

WELL LOCATION:

sec. 24 T 6 N R 9 E  
 12 miles SW of CLARA  
 (distance) (direction) (nearest town)

WELL PURPOSE:

Home (home, irrigation, municipal, industrial)

WELL COMPLETION DATA:

- (1) diameter (inches) 2"
- (2) total depth (feet) 103'
- (3) static water level (feet) 38' below top of ground.
- (4) casing PVC 53' (material) (depth)  
 2" (size) if telescope see back.
- (5) screen 10' 53' (length) (depth to top)  
 2" PVC (size) (material)
- (6) pump 1 12 (HP) (yield gpm)  
 220 AC (type power)
- (7) electric log No (yes or no)

(organization running log)

(8) how well bottom plugged

RECEIVED


NOV 11 1977

DRILLERS REMARKS:

MISS. Bd. OF WATER COMM

If well telescopes please sketch and show depths.

GROUND LEVEL

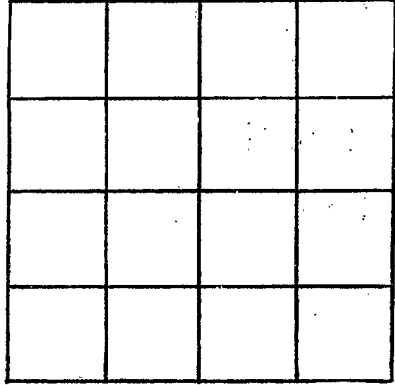

SECTION \_\_\_\_\_

Please indicate well location X.

ADDITIONAL INFORMATION

If more than one screen,  
show locations of each on sketch.