

WAYNE
2005 V
04-11-79

MISSISSIPPI  
BOARD OF WATER COMMISSIONERS  
416 North State Street  
Jackson, Mississippi 39201

WATER WELL DRILLERS LOG

WAYNE

4-11 1979 Griner Drilling ~~Simpson~~  
 date well completed firm name county well located

LANDOWNER:	description of formations encountered	from	to
Brandon Company	Clay + sand	0	21
(mailing address)	clay	21	42
WELL LOCATION: 340 N + 470 W	clay	42	189
sec. 11 T. 6 N R. 9 E of	sand + p. gravel	189	210
Near Richton SE/4	sand	210	231
(distance) (direction) (nearest town)	sand, p. gravel	231	273
WELL PURPOSE: oil field supply	sand	273	315
(home, irrigation, municipal, industrial)	little sand-ely	315	336
WELL COMPLETION DATA:			
(1) diameter (inches) 3"			
(2) total depth (feet) 336'			
(3) static water level (feet) 80' below above top of ground.			
(4) casing steel, 315' (material) (depth)			
3" if telescope see back. (size)			
(5) screen 42', 273' (length) (depth to top)			
3" perforated (size) (material)			
(6) pump - 75 (HP) (yield gpm)			
AC (type power)			
(7) electric log - (yes or no)			
(organization running log)			
(8) how well bottom plugged orange peel			
DRILLERS REMARKS:			


Miss. Board of Water Comm.

MAY - 9 1979

RECEIVED

If well telescopes please sketch and show depths.

GROUND LEVEL

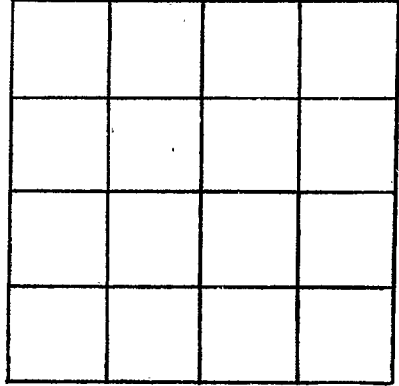

SECTION \_\_\_\_\_

Please indicate well location X.

ADDITIONAL INFORMATION

A series of horizontal lines providing space for additional information.

If more than one screen, show locations of each on sketch.