

MISSISSIPPI DEPARTMENT OF NATURAL RESOURCES

Bureau of Land and Water Resources

Southport Mall

P.O. Box 10631

Jackson, Mississippi 39209

WATER WELL DRILLERS LOG

WAYNE  
V 2000

Nov 18 1985 date well completed  
 85 Oak Drilling Co. firm name  
 Itasca county well located

LANDOWNER: Curtis Brewer  
 Rt 2 Dickton  
 (mailing address)

description of formations encountered	from	to
med clay	0	10
med clay with sh. clay	10	95
thin med sand & clay	95	99
clay	99	104

WELL LOCATION:  
 sec 35 T 6 N R 9 E  
 12 miles SW of Clarks  
 (distance) (direction) (nearest town)

72" PVC dye pipe

WELL PURPOSE: home  
 (home, irrigation, municipal, industrial)

- WELL COMPLETION DATA:
- (1) diameter (inches) 2"
  - (2) total depth (feet) 104'
  - (3) static water level (feet) 62' below top of ground
  - (4) casing PVC 95' (material), (depth)  
 2" 4" 2" hard pipe below screen (size) if telescope see back.
  - (5) screen 5' 95' (length), (depth to top)  
 2" belt SS (size), (material)
  - (6) pump 1 (HP), 9 (yield gpm)  
 elec. (type power)
  - (7) electric log no (yes or no)  
 (organization running log)
  - (8) how well bottom plugged  
 2' back wash material

RECEIVED


NOV 22 1985

DRILLERS REMARKS:

Department of Natural Resources  
 Bureau of Land & Water Resources

If well telescopes please sketch and show depths.

GROUND LEVEL

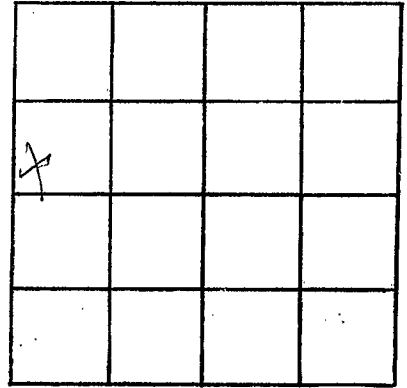

SECTION 35

Please indicate well location X.

ADDITIONAL INFORMATION

If more than one screen, show locations of each on sketch.