

WAYNE MISSISSIPPI BOARD OF WATER COMMISSIONERS

W3

5-15-64

WATER WELL DRILLERS LOG

Date: May 15, 1964, Driller: Porter Drilling & Log County: Wayne
(Name)

- (1) Owner of Land: Ernest Brewer
(Name)
211 Rickett, Miss
(Address)
- (2) Location: SW 1/4, SE 1/4, Sec. 25 T 6 R 8,
9 miles south of Clava
(distance) (direction) (Nearest Town)
- (3) Topography: Hilly
(Hilly) (Flat) (Level)
- (4) Purpose of Well: domestic
(Domestic Irrigation
Municipal, Industrial, Other)

Description & Color of Materials
Sand, Clay, Red Clay, Shell, etc.

Thick-
ness
Feet

Depth
Feet

<u>red clay</u>	<u>16</u>	<u>16</u>
<u>sand</u>	<u>11</u>	<u>27</u>

Information upon completion of well:


- (1) Diameter 2" inches.
- (2) Total Depth 27' feet.
- (3) Water Level 19' feet below top of ground.
- (4) Cased to 24', Size 2"
- (5) Screen: Size 1 1/4, Length 3'
- (6) Were any formations sealed against pollution?
Johnson S.S.

yes, no.

If YES depth of formation _____

Why _____

Drillers Remarks: _____

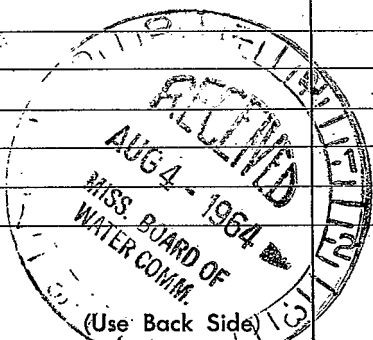

Well No.

