

WAYNE
WA
6-29-66

MISSISSIPPI BOARD OF WATER COMMISSIONERS

WATER WELL DRILLERS LOG

Date: June 29, 1966, Driller: Porter Drilling & Log Co County: Wayne
(Name)

(1) Owner of Land: Ray Perry
(Name)
Rt 3 Waynesboro
(Address)

(2) Location: NW 1/4, NE 1/4, Sec. 11 T. 6 R. 8
8 miles SW of Clare
(distance) (direction) (Nearest Town)

(3) Topography: flat
(Hilly) (Flat) (Level)

(4) Purpose of Well: domestic
(Domestic Irrigation
Municipal, Industrial, Other)

Description & Color of Materials Sand, Clay, Red Clay, Shell, etc.	Thick- ness Feet	Depth Feet
<u>red clay</u>	<u>4</u>	<u>4</u>
<u>chals</u>	<u>22</u>	<u>26</u>
<u>grey sand</u>	<u>14</u>	<u>40</u>
<u>blue chals</u>	<u>2</u>	<u>42</u>

Information upon completion of well:

(1) Diameter 2" inches.

(2) Total Depth 38' feet.

(3) Water Level 12' feet below top of ground.

(4) Cased to 32', Size 2"


(5) Screen: Size 1 1/4, Length 6'
60 ga

(6) Were any formations sealed against pollution?
X yes, X no.

If YES depth of formation _____

Why _____

Drillers Remarks: _____

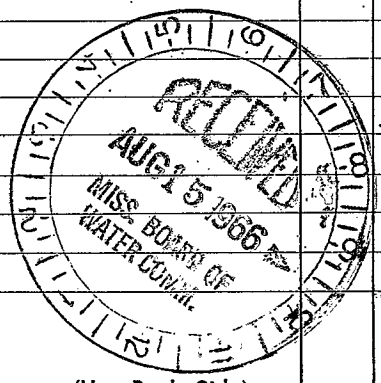

(Use Back Side)

Well No.

