

MISSISSIPPI
BOARD OF WATER COMMISSIONERS
416 North State Street
Jackson, Mississippi 39201

CODED

CODED

WATER WELL DRILLERS LOG

Wayne
W 7
1-3-69

Jan 3 1969 Porter Drilling & Log Wayne
date well completed firm name county well located


LANDOWNER: <u>Clinton Walters</u>	description of formations encountered	from	to
<u>Box 3 Hammersburg Miss</u> (mailing address)	<u>red clay</u>	<u>0</u>	<u>8</u>
WELL LOCATION: sec. <u>11</u> T <u>6</u> N R. <u>8</u> <u>6</u> miles <u>SW</u> of <u>Clara</u> (distance) (direction) (nearest town)	<u>sand & chalk</u>	<u>9</u>	<u>30</u>
WELL PURPOSE: <u>Home</u> (home, irrigation, municipal, industrial)	<u>Chalk</u>	<u>30</u>	<u>40</u>
WELL COMPLETION DATA: (1) diameter (inches) <u>2"</u>	<u>sand & chalk</u>	<u>40</u>	<u>46</u>
(2) total depth (feet) <u>70'</u>	<u>sand</u>	<u>46</u>	<u>70</u>
(3) static water level (feet) <u>37</u> <u>below</u> top of ground.	<u>start on chalk</u>		
(4) casing <u>steel</u> , <u>63'</u> (material) (depth)	<u>sand would not produce</u>		
<u>2"</u> (size) If telescope see back.	<u>except at bottom</u>		
(5) screen <u>6'</u> , <u>64</u> (length) (depth to top)	<u>2' 1 1/2" long gauge under</u>		
<u>1 1/2"</u> (size) <u>80 gm S.S.</u> (material)	<u>cas. height in well packer</u>		
(6) pump <u>3/4</u> , <u>8</u> (HP) (yield gpm)	<u>CODED</u>		
<u>elec.</u> (type power)			
(7) electric log <u>no</u> (yes or no)			
(8) how well bottom plugged <u>flush cement</u>			
DRILLERS REMARKS:			

FFR - 3 1969

MISS. BD. U.
REGISTERED PROFESSIONAL
WATER WELL DRILLER

If well telescopes please sketch and show depths.

GROUND LEVEL

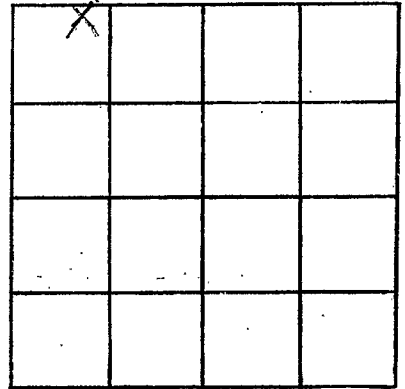

SECTION 11

Please indicate well location X.

ADDITIONAL INFORMATION

If more than one screen,
show locations of each on sketch.