

WAYNE
W 9
5-17-71

MISSISSIPPI
BOARD OF WATER COMMISSIONERS
416 North State Street
Jackson, Mississippi 39201

CODED

WATER WELL DRILLERS LOG

May 17 1971 19 Bohr Drilling & Log Wayne
date well completed firm name county well located

LANDOWNER: Richard Garry
Box 321 Argusboro Miss.
(mailing address)

description of formations encountered	from	to
<u>chalk</u>	<u>0</u>	<u>30</u>
<u>chalk & sand</u>	<u>30</u>	<u>36</u>
<u>sand with some chalk</u>	<u>36</u>	<u>45</u>
<u>stratified chalk</u>		

WELL LOCATION:
sec. 11 T. 6 N. R. 8 E.
5 miles SW of Clava
(distance) (direction) (nearest town)

WELL PURPOSE: Home
(home, irrigation, municipal, industrial)

WELL COMPLETION DATA:

(1) diameter (inches) 2"

(2) total depth (feet) 44

(3) static water level (feet) 22 below above top of ground.

(4) casing galvanic 39'
(material) (depth)
2" if telescope see back.
(size)

(5) screen 5' 39'
(length) (depth to top)
1/4" 6 slot S.S.
(size) (material)

(6) pump 1 6
(HP) (yield gpm)
elec
(type power)

(7) electric log no
(yes or no)

(organization running log)

(8) how well bottom plugged
flush sand

5' 1/2" slot SS
screwed on end of casing
35' 1" plastic drop
pipe


CODED

JUN 1 1971

DRILLERS REMARKS:

If well telescopes please sketch and show depths.

GROUND LEVEL

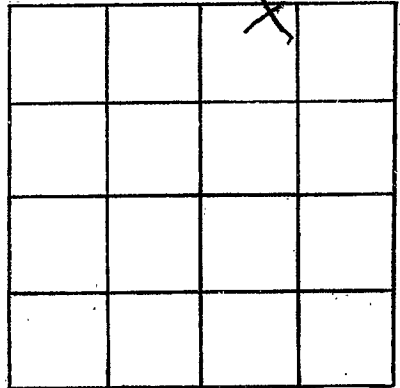

SECTION 11

Please indicate well location X.

ADDITIONAL INFORMATION

If more than one screen, show locations of each on sketch.