

WAYNE  
W 10  
6-23-71

MISSISSIPPI  
BOARD OF WATER COMMISSIONERS  
416 North State Street  
Jackson, Mississippi 39201

**CODED**

WATER WELL DRILLERS LOG

June 23 1971 Barber Drilling Log Wayne  
date well completed firm name county well located

LANDOWNER: Wayne Penny description of formations encountered from to

At 3 Hammockville (mailing address)  
Clay  
Limestone sand  
Chalk  
12 77  
77 94  
fine sand & chalk streak  
slightly on chalk

WELL LOCATION:  
sec. 3 T. 60 N. R. 8 E. W. 6  
6 miles SW of Clay  
(distance) (direction) (nearest town)

WELL PURPOSE: Home  
(home, irrigation, municipal, industrial)

WELL COMPLETION DATA:  
(1) diameter (inches) 2"  
(2) total depth (feet) 74'  
(3) static water level (feet) 35' below top of ground.  
(4) casing steel 83'  
(material) (depth)  
2" if telescope see back.  
(size)  
(5) screen 6" 86'  
(length) (depth to top)  
1/4" 20 ga. S.S.  
(size) (material)  
(6) pump 1/2 8  
(HP) (yield gpm)  
elec.  
(type power)  
(7) electric log no  
(yes or no)  
  
(organization running log)

6' 1/4" 20 ga SS well  
2' 1/4" pipe below 6  
5' 1" log gauge above  
fracture with gravel  
42' 1/4" down gauge

**CODED**

(8) how well bottom plugged  
2' apt with plug


DRILLERS REMARKS:

JUN 24 1971

MISS. EP. CO.  
WATER CONTROL

If well telescopes please sketch and show depths.

GROUND LEVEL

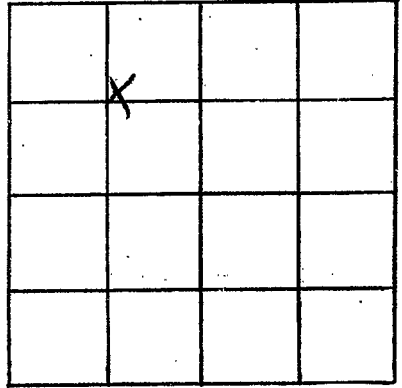

SECTION 3

Please indicate well location X.

ADDITIONAL INFORMATION

If more than one screen, show locations of each on sketch.