

Wayne
W 14
7-31-72

MISSISSIPPI
BOARD OF WATER COMMISSIONERS
416 North State Street
Jackson, Mississippi 39201

CODED

WATER WELL DRILLERS LOG

July 31 1972 date well completed
Porter Drilling & Log firm name
Wayne county well located

LANDOWNER: Leonard
Bradley
243 Wainwright Miss
(mailing address)

description of formations encountered	from	to
red clay	0	15
sand	15	45
sand & pea gravel	45	57
stop on chalk		
5' 1/4" 8 slot SS		
screwed on end of Cas		
4 2' 1/4" drop pipe		

WELL LOCATION:
sec. 10 T. 60 N. R. 8 E
6 miles SW Clara
(distance) (direction) (nearest town)

WELL PURPOSE: home
(home, irrigation, municipal, industrial)

- WELL COMPLETION DATA:
- (1) diameter (inches) 2"
 - (2) total depth (feet) 57
 - (3) static water level (feet) 32 below top of ground.
 - (4) casing steel 52 (material) (depth)
2" (size) if telescope see back.
 - (5) screen 5' 52' (length) (depth to top)
1 1/4" 8 slot SS (size) (material)
 - (6) pump 1 15 (HP) (yield gpm)
elec. (type power)
 - (7) electric log no (yes or no)
- (organization running log)

(8) how well bottom plugged:
flush cement

DRILLERS REMARKS:


CODED

SEP 5 1972

MISS. DE. OF
WATER COMM.

If well telescopes please sketch and show depths.

GROUND LEVEL

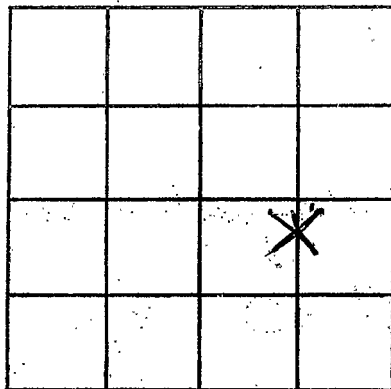

SECTION 10

Please indicate well location X.

ADDITIONAL INFORMATION

If more than one screen,
show locations of each on sketch.