

MISSISSIPPI
BOARD OF WATER COMMISSIONERS
416 North State Street
Jackson, Mississippi 39201

CODED

WATER WELL DRILLERS LOG

WAYNE
W 15
3-15-73

March 15 1973 Bohr Drilling, Inc. Wayne
date well completed firm name county well located


LANDOWNER: <u>J. H. Walley</u>	description of formations encountered	from	to
<u>RT 3 Hainesboro Miss</u> (mailing address)	<u>red clay</u> <u>red sand</u> <u>fine clean sand</u> <u>stop on chalk</u>	<u>0</u> <u>15</u> <u>35</u> <u>45</u>	<u>15</u> <u>35</u> <u>45</u>
WELL LOCATION: sec. <u>4</u> T <u>6</u> N R. <u>8</u> E <u>7</u> miles <u>SW</u> of <u>Clara</u> (distance) (direction) (nearest town)	<u>3' 1 1/2" bolt SS</u>		
WELL PURPOSE: <u>None</u> (home, irrigation, municipal, industrial)	<u>screw on end of cas.</u>		
WELL COMPLETION DATA:	<u>35' 1" dog pipe</u>		
(1) diameter (inches) <u>2"</u>			
(2) total depth (feet) <u>45'</u>			
(3) static water level (feet) <u>30'</u> below top of ground.			
(4) casing <u>steel</u> <u>42'</u> (material) (depth)			
<u>2"</u> if telescope see back. (size)			
(5) screen <u>3'</u> <u>42'</u> (length) (depth to top)			
<u>1 1/4"</u> <u>6 bolt SS</u> (size) (material)			
(6) pump <u>1</u> <u>12</u> (HP) (yield gpm)			
<u>elec.</u> (type power)			
(7) electric log <u>no</u> (yes or no)			
(organization running log)			
(8) how well bottom plugged <u>flush point</u>			
DRILLERS REMARKS:			

CODED

MISS. SD. 22
1 15/73

If well telescopes please sketch and show depths.

GROUND LEVEL

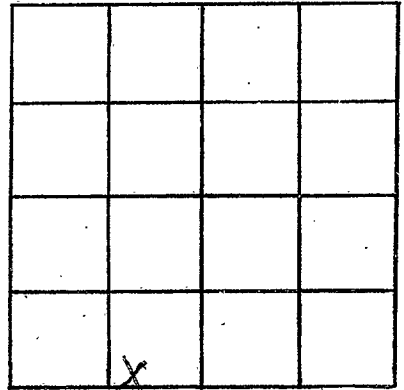

SECTION 4

Please indicate well location X.

ADDITIONAL INFORMATION

If more than one screen, show locations of each on sketch.