

BOARD OF WATER COMMISSIONERS

416 North State Street
Jackson, Mississippi 39201

CODED

WAYNE

W16

WATER WELL DRILLERS LOG

4-12-73

April 12 1973
date well completed

Robert Drilling & Log. Wayne
firm name county well located

LANDOWNER: J. S. Walker

description of formations encountered

from to

L. M. Smith Contractor

213 W. Monroehoro
(mailing address)

most clay 0 15
brown chalk 15 200
orange chalks 200 290
brown sandstone 290 315
chalks
most clean sand 315 331
shaly white
shell in sand

WELL LOCATION:

sec. 10 T. 60 N. R. 2 E. S. 6
6 miles SW of Clarks
(distance) (direction) (nearest town)

WELL PURPOSE: Home
(home, irrigation, municipal, industrial)

WELL COMPLETION DATA:

- (1) diameter (inches) 2"
- (2) total depth (feet) 331'
- (3) static water level (feet) 113' below top of ground
- (4) casing steel 317' (material) (depth)
2" If telescope see back. (size)
- (5) screen 12' 319' (length) (depth to top)
1/4" 20 ga SS. (size) (material)
- (6) pump 1/2 HP 5 (yield gpm)
elec. (type power)
- (7) electric log (yes or no)

126' 1/4" diameter pipe
12' 80 ga screen
with 4' 1/4" length
in with packer

CODED

(organization running log)


(8) how well bottom plugged
plugged

DRILLERS REMARKS:

MISS. 20 22
MAY 1973

If well telescopes please sketch and show depths.

GROUND LEVEL

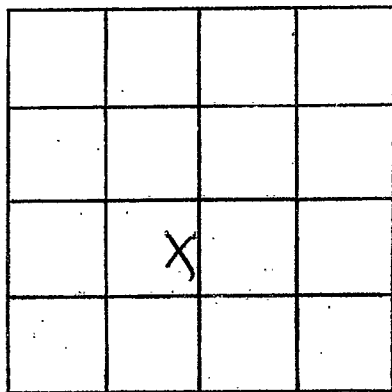

SECTION 10

Please indicate well location X.

ADDITIONAL INFORMATION

If more than one screen,
show locations of each on sketch.