

MISSISSIPPI  
BOARD OF WATER COMMISSIONERS  
416 North State Street  
Jackson, Mississippi 39201

**CODED**

WAYNE

W17

4-7-73

WATER WELL DRILLERS LOG

April 7 1973 Orbit Drilling & Supply Wayne  
date well completed firm name county well located

LANDOWNER: Charles Halliday

description of formations encountered

from

to

Rt 321 near Ashboro  
(mailing address)

red clay sand 0 20  
blue chert 20 290

WELL LOCATION:

sec. 9 T. 6 N. R. 8 E. S. 1 W.  
7 miles SW of Clara  
(distance) (direction) (nearest town)

red chert 290 320  
blue chert 320 344  
red fine clean sand 344 350  
stop at on chert

WELL PURPOSE: dom  
(home, irrigation, municipal, industrial)

WELL COMPLETION DATA:

- (1) diameter (inches) 2"
- (2) total depth (feet) 350'
- (3) static water level (feet) 130 <sup>below</sup> <sub>above</sub> top of ground.
- (4) casing steel, 344'  
(material) (depth)  
2" If telescope see back.  
(size)
- (5) screen 6', 344'  
(length) (depth to top)  
1/4", 20 ga S.S.  
(size) (material)
- (6) pump 3 1/2 3 1/2  
(HP) (yield gpm)  
elec.  
(type power)
- (7) electric log no  
(yes or no)

Cylinder set at 168'  
well packer below  
to keep hole  
6' 20 ga S.S. screen  
next in well packer

**CODED**


(organization running log)

(8) how well bottom plugged: flush ground

DRILLERS REMARKS:

If well telescopes please sketch and show depths.

GROUND LEVEL

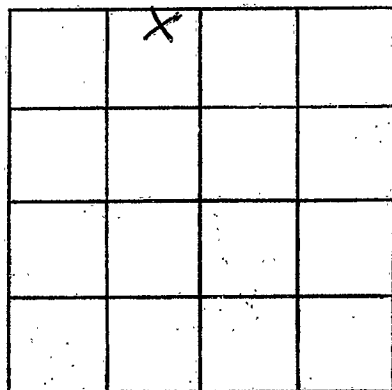

SECTION 9

Please indicate well location X.

ADDITIONAL INFORMATION

If more than one screen, show locations of each on sketch.