

WAYNE

W 18

7-11-73

MISSISSIPPI BOARD OF WATER COMMISSIONERS
416 North State Street
Jackson, Mississippi 39201

CODED SEP 12 1973

WATER WELL DRILLERS LOG

MISS. BD. OF WATER COMMISSIONERS

July 11 1973 date well completed
Porter Drilling Co. firm name
Wayne county well located

LANDOWNER Arthur Brewer

description of formations encountered

from

to

Box 3 Stagnamore Min (mailing address)

rest clay	0	15'
rest clay	15	19
sand	19	23
shale		23
rest chalk	23	35
blue chalk	35	65
red chalk fine sand	65	85
chalk	85	99
rest	99	100
hard sand little shell	100	122
stagnant chalky sand		

WELL LOCATION:

sec. 10 T 60 N R 8 E S 6 miles SW of Osborn (distance) (direction) (nearest town)

WELL PURPOSE: home & stock (home, irrigation, municipal, industrial)

WELL COMPLETION DATA:

- (1) diameter (inches) 2"
- (2) total depth (feet) 132'
- (3) static water level (feet) 85' below top of ground
- (4) casing steel 126' (material) (depth)
2" (size) if telescope see back.
- (5) screen 5' 127' (length) (depth to top)
1 1/4" (size) half S.S. (material)
- (6) pump 2 (HP) 12 (yield gpm)
slor (type power)
- (7) electric log no (yes or no)

5' 1/4" blast SS with
3' 1/4" log hole in
well
CODED
105' 1/4" drop gauge


(organization running log)

(8) how well bottom plugged

DRILLERS REMARKS:

If well telescopes please sketch and show depths.

GROUND LEVEL

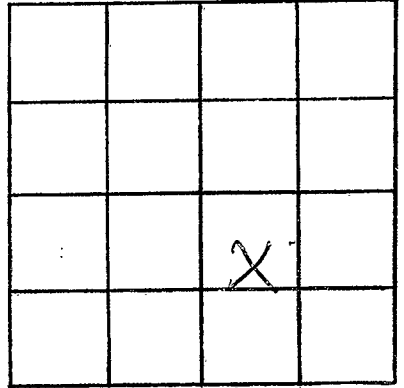

SECTION 10

Please indicate well location X.

ADDITIONAL INFORMATION

If more than one screen,
show locations of each on sketch.