

WAYNE
W 19
1-22-74

MISSISSIPPI
BOARD OF WATER COMMISSIONERS CODED
416 North State Street
Jackson, Mississippi 39201

WATER WELL DRILLERS LOG

Jan 22 1974 Date well completed
Doubt Drilling firm name
Wayne county well located

LANDOWNER: W. S. Stohaley
Nestley Cochran home
At 3 Hammond Mrs
(mailing address)

description of formations encountered	from	to
red chalk	0	32
blue chalk	32	157
sand & chalk streaks	157	168
most clean sand	168	199
stagnant white steel		
oil sand		
22' 1" P.V.C. large pipe		
10' P.V.C. 10 slot		
screen with back wash		
water & shell formed		

WELL LOCATION:
sec. 5 T. 6 N. R. 8 E
8 miles SW of Clara
(distance) (direction) (nearest town)

WELL PURPOSE: home
(home, irrigation, municipal, industrial)

WELL COMPLETION DATA:

(1) diameter (inches) 2"

(2) total depth (feet) 199'

(3) static water level (feet) 75' below top of ground.

(4) casing P.V.C. 189'
(material) (depth)
2" if telescope see back.
(size)

(5) screen 10', 189'
(length) (depth to top)
2", P.V.C.
(size) (material)

(6) pump 1 6
(HP) (yield gpm)
elec
(type power)

(7) electric log no
(yes or no)

(organization running log)

(8) how well bottom plugged
back wash water

CODED


JAN 29 1974

MISS. Bd. OF WATER COMM.

DRILLERS REMARKS:

If well telescopes please sketch and show depths.

GROUND LEVEL

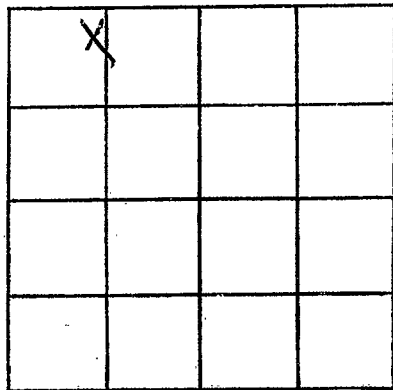

SECTION 5

Please indicate well location X.

ADDITIONAL INFORMATION

If more than one screen, show locations of each on sketch.