

WAYNE
W 20
3-4-74

MISSISSIPPI
BOARD OF WATER COMMISSIONERS
416 North State Street
Jackson, Mississippi 39201

WATER WELL DRILLERS LOG CODED

March 4 1974 Prots. Drilling Co. Wayne
date well completed firm name county well located

LANDOWNER: 2200 Ocean

Williams

description of formations encountered

from

to

211 Wainwright Dr Miss
(mailing address)

clay to sand

0 5

WELL LOCATION:

sec 23 T 9 N S R 8 E W
7 miles NW of Waynesboro
(distance) (direction) (nearest town)

clay

5 21

shale to chert

21 26

WELL PURPOSE: none
(home, irrigation, municipal, industrial)

WELL COMPLETION DATA:


- (1) diameter (inches) 2"
- (2) total depth (feet) 35'
- (3) static water level (feet) 10' (below/above top of ground)
- (4) casing PVC 30'
(material) (depth)
2" (size) If telescope see back.
- (5) screen 5' 30'
(length) (depth to top)
1/4" galv SS (size) (material)
- (6) pump 1 8 1/2
(HP) (yield gpm)
also (type power)
- (7) electric log no
(yes or no)

22' 1" PVC clay pipe

CODED

(organization running log)

(8) how well bottom plugged
flat ground

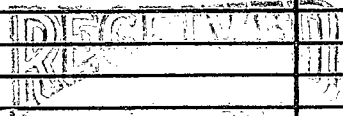


MAR 11 1974

DRILLERS REMARKS:

MISS. BD. OF WATER COMMISSIONERS

If well telescopes please sketch and show depths.

GROUND LEVEL

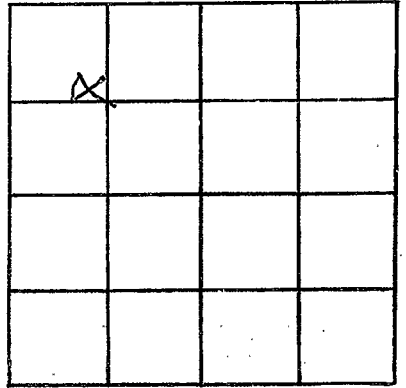

SECTION 23

Please indicate well location X.

ADDITIONAL INFORMATION

If more than one screen,
show locations of each on sketch.