

WAYNE  
W 21  
4-26-74

MISSISSIPPI  
BOARD OF WATER COMMISSIONERS CODED  
416 North State Street  
Jackson, Mississippi 39201

WATER WELL DRILLERS LOG

APR 26, 1974  
date well completed

McILWAIN WATER WELL SERVICE

WAYNE

RT. 2 BOX 37

county well located

WAYNESBORO, MISS. 39367

description of formations encountered

from

to

LANDOWNER:

Mrs BESSIE BOYLES

RED CLAY

0

8

RT 3 WAYNESBORO  
(mailing address)

MIXED CLAY

8

12

WELL LOCATION:

sec. 9 T. 6 N. R. 8 E.  
8 miles SW of CLARA  
(distance) (direction) (nearest town)

CLAY WITH SAND STREAKS

12

28

CLAY

28

32

WELL PURPOSE: HOME  
(home, irrigation, municipal, industrial)

COARSE SAND

32

45

WELL COMPLETION DATA:

- diameter (inches) 2"
- total depth (feet) 45
- static water level (feet) 23' below top of ground.
- casing PVC 40' (material), (depth)  
2" (size) If telescope see back.
- screen 5' 40' (length), (depth to top)  
2" (size), PVC .010 (material)
- pump 1 (HP) 10 (yield gpm)  
220 AC (type power)
- electric log NO (yes or no)

CODED


(organization running log)

(8) how well bottom plugged

DRILLERS REMARKS:

If well telescopes please sketch and show depths.

GROUND LEVEL

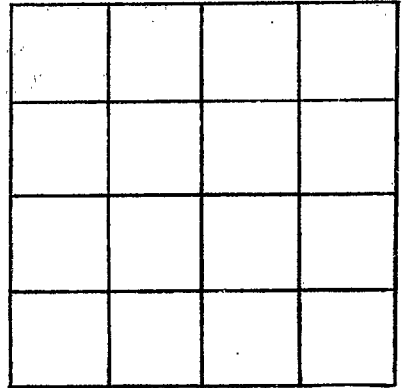

SECTION \_\_\_\_\_

Please indicate well location X.

ADDITIONAL INFORMATION

If more than one screen, show locations of each on sketch.