

WAYNE
 W22
 8-14-74

MISSISSIPPI
 BOARD OF WATER COMMISSIONERS
 416 North State Street
 Jackson, Mississippi 39201

CODED

WATER WELL DRILLERS LOG
 McILWAIN WATER WELL SERVICE


Aug 14, 1974 19 RT. 2, BOX 37 WAYNE
 date well completed WAYNESBORO, MISS. 39367 county well located

LANDOWNER:	description of formations encountered	from	to
ELMER PITTS			
Waynesboro, Miss. (mailing address)	Sandy Clay	0	4
	Clay	4	10
WELL LOCATION: sec. 9 T. 4 N R. 8 E 10 miles SW of CLARA (distance) (direction) (nearest town)	Red sand and clay streaks	10	25
	Coarse sand	25	45
WELL PURPOSE: HOME (home, irrigation, municipal, industrial)			
WELL COMPLETION DATA:			
(1) diameter (inches) 2"			
(2) total depth (feet) 45'			
(3) static water level (feet) 23' below top of ground.			
(4) casing PVC 40' (material) (depth) 2" If telescope see back. (size)			
(5) screen 5' 40' (length) (depth to top) 2" PVC #008 (size) (material)			
(6) pump 1 12 (HP) (yield gpm) 220 AC (type power)			
(7) electric log No (yes or no)			
(organization running log)			
(8) how well bottom plugged			
DRILLERS REMARKS:			

RECEIVED
 SEP 25 1974

If well telescopes please sketch and show depths.

GROUND LEVEL

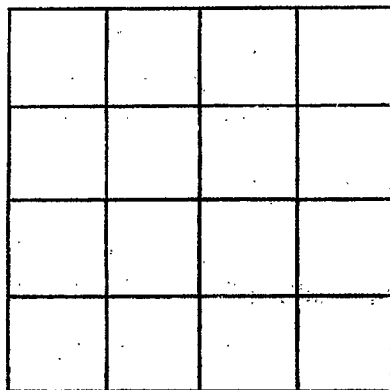

SECTION _____

Please indicate well location X.

ADDITIONAL INFORMATION

If more than one screen, show locations of each on sketch.