

WAYNE
W 23
8-20-74

MISSISSIPPI
 BOARD OF WATER COMMISSIONERS
 416 North State Street
 Jackson, Mississippi 39201

CODED

McILWAIN WATER WELL SERVICE
 WATER WELL DRILLERS LOG

AUG 20
 date well completed

1974

RT. 2, BOX 37

WAYNESBORO, MISS. 39367

WAYNE
 county/well located

LANDOWNER:
COVINTA FREEWILL BAP. CHURCH
WAYNESBORO, MISS.
 (mailing address)

description of formations encountered	from	to
<u>Sandy clay</u>	<u>0</u>	<u>8</u>
<u>clay</u>	<u>8</u>	<u>10</u>
<u>Sand</u>	<u>10</u>	<u>36</u>

WELL LOCATION:
 sec. 9 T. 6 N R. 8 E
10 miles SW of CLARA
 (distance) (direction) (nearest town)

WELL PURPOSE: HOME
 (home, irrigation, municipal, industrial)


- WELL COMPLETION DATA:
- (1) diameter (inches) 2"
 - (2) total depth (feet) 36'
 - (3) static water level (feet) 29 below above
 top of ground.
 - (4) casing PVC, 31'
 (material) (depth)
2" if telescope see back.
 (size)
 - (5) screen 5', 31'
 (length) (depth to top)
2", PVC .068
 (size) (material)
 - (6) pump 1, 10
 (HP) (yield gpm)
110 AC
 (type power)
 - (7) electric log No
 (yes or no)
- (organization running log)
- (8) how well bottom plugged _____

DRILLERS REMARKS:

RECEIVED
SEP 25 1974
 MISS. Bd. OF WATER COMMISSIONERS

If well telescopes please sketch and show depths.

GROUND LEVEL

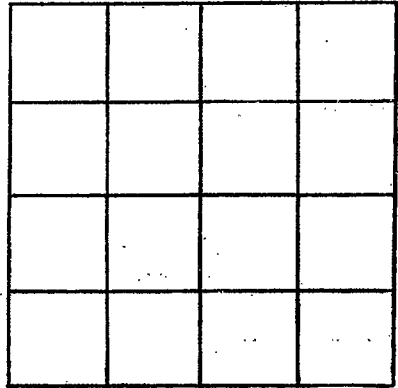

SECTION _____

Please indicate well location X.

ADDITIONAL INFORMATION

If more than one screen, show locations of each on sketch.