

WAYNE  
W24  
11/1/74

MISSISSIPPI  
BOARD OF WATER COMMISSIONERS  
416 North State Street  
Jackson, Mississippi 39201

CODED

WATER WELL DRILLERS LOG

McILWAIN WATER WELL SERVICE

WAYNE

Nov 1, 1974  
date well completed

RT. 2 BOX 37  
WAYNESBORO MISS. 39367

county well located

LANDOWNER:  
James Egell  
Rt 3 Waynesboro, Miss  
(mailing address)

description of formations encountered	from	to
Red Clay	0	5
Bank Clay	5	12
Sand	12	44

WELL LOCATION:  
sec. 9 T. 6 N R. 8 E  
10 miles SW of CLARA  
(distance) (direction) (nearest town)

WELL PURPOSE: Home  
(home, irrigation, municipal, industrial)


- WELL COMPLETION DATA:
- (1) diameter (inches) 2"
  - (2) total depth (feet) 44'
  - (3) static water level (feet) 21' below top of ground.
  - (4) casing PVC 39' (material) (depth)  
2" (size) If telescope see back.
  - (5) screen 5' 1" 39' (length) (depth to top)  
2" (size) PVC .008 (material)
  - (6) pump 3/4 10 (HP) (yield gpm)  
220 AC (type power)
  - (7) electric log no (yes or no)
  - (8) how well bottom plugged

DRILLERS REMARKS:

RECORDED  
NOV - 7 1974

If well telescopes please sketch and show depths.

GROUND LEVEL

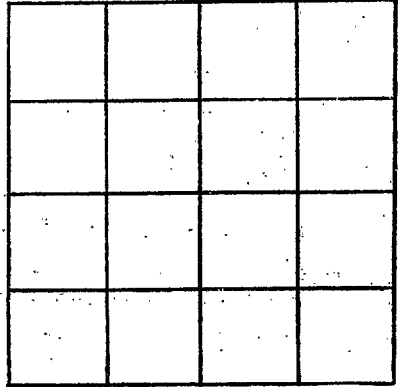

SECTION \_\_\_\_\_

Please indicate well location X.

ADDITIONAL INFORMATION

If more than one screen, show locations of each on sketch.