

Wayne  
W 26  
7-16-75

CODED

MISSISSIPPI  
BOARD OF WATER COMMISSIONERS  
416 North State Street  
Jackson, Mississippi 39201

WATER WELL DRILLERS LOG  
McILWAIN WATER WELL SERVICE

July 16, 1975 19 Wayne county well located  
date well completed  
Rt. 2 BOX 37  
WAYNESBORO MISS. 39367


LANDOWNER:	description of formations encountered	from	to
CHARLES Brewer	Yellow Clay	0	8
Rt 3 Waynesboro, Miss (mailing address)	Mixed clay	8	15
WELL LOCATION: sec. 2 T. 6 N R. 8 E 13P	Hard grey clay	15	45
7 miles SW of CLARA (distance) (direction) (nearest town)	Blue clay	45	70
WELL PURPOSE: HOME (home, irrigation, municipal, industrial)	Brown clay	70	85
WELL COMPLETION DATA:	Blue clay	85	92
(1) diameter (inches) 2"	Med sand	92	103
(2) total depth (feet) 103'			
(3) static water level (feet) 32 below above top of ground.			
(4) casing PVC 98' (material) (depth) 2" if telescope see back. (size)			
(5) screen 5' 98' (length) (depth to top) 2" PVC .008 Slot (size) (material)			
(6) pump 1 10 (HP) (yield gpm) 110 AC (type power)			
(7) electric log 470 (yes or no)			
(organization running log)			
(8) how well bottom plugged			
DRILLERS REMARKS:			

DECLINING  
JUL 24 1975

MISS. Bd. OF WATER COMM.

If well telescopes please sketch and show depths.

GROUND LEVEL

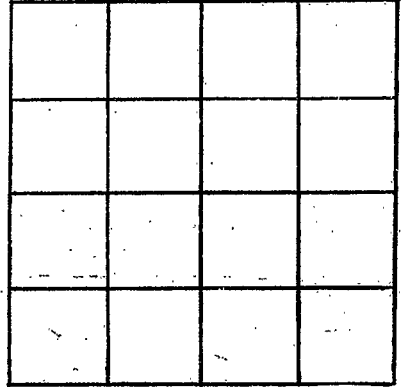

SECTION \_\_\_\_\_

Please indicate well location X.

ADDITIONAL INFORMATION

If more than one screen, show locations of each on sketch.