

MISSISSIPPI DEPARTMENT OF NATURAL RESOURCES

Bureau of Land and Water Resources

Southport Mall

P.O. Box 10631

Jackson, Mississippi 39209

CODED

WATER WELL DRILLERS LOG

Griner Drilling Service, Inc.

Wayne

WAYNE  
W 28  
9-23-81

9-23-81 date well completed

Griner Drilling Service, Inc. firm name

Wayne county well located

LANDOWNER:

Callons Petroleum Products Department  
P.O. Box 1287  
Natchez, Miss 39120

description of formations encountered

from

to

chalk, streaked sand

0 280

WELL LOCATION: 1919' S + 1980' E of

sand

280 365

sec. 36 T 6 N R 8 E NW/4

chalk

365 392

No. 1 U.S.A. Crater southwest of Natchez, Miss

WELL PURPOSE: oilfield supply  
(home, irrigation, municipal, industrial)

WELL COMPLETION DATA:

- (1) diameter (inches) 3"
- (2) total depth (feet) 392'
- (3) static water level (feet) 60' (below top of ground)

CODED

- (4) casing steel 357' (material), (depth)  
3" (size) if telescope see back.

- (5) screen 42' 315' (length), (depth to top)  
3" perforated (size), (material)

- (6) pump — 75 (HP), (yield gpm)  
AC (type power)

- (7) electric log — (yes or no)  
(organization running log)

- (8) how well bottom plugged Orange  
peel

DRILLERS REMARKS:


DEPT. OF NATURAL RESOURCES  
BUREAU OF LAND & WATER RESOURCES

OCT - 6 1981

RECEIVED

If well telescopes please sketch and show depths.

GROUND LEVEL

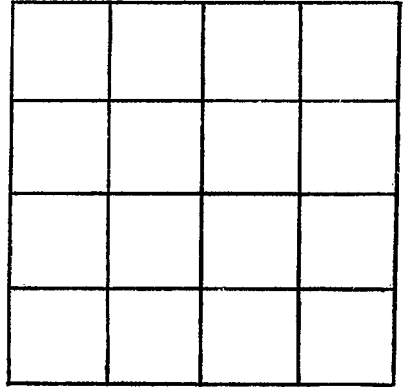

SECTION \_\_\_\_\_

Please indicate well location X.

ADDITIONAL INFORMATION

If more than one screen,  
show locations of each on sketch.