

W 29
Wayne
8-25-85

MISSISSIPPI
BOARD OF WATER COMMISSIONERS
416 North State Street
Jackson, Mississippi 39201

CODED

WATER WELL DRILLERS LOG

Griner Drilling
Service, Inc.

Wayne

8-25-85
date well completed

firm name


county well located

LANDOWNER:	description of formations encountered	from	to
SUN Exploration + Production 1201 Northwest Loop Longview, Texas 75604 (mailing address)	fill	0	10
WELL LOCATION: 1651' N + 7747' W sec. 7 T. 6 N. R. 8 E. S. 10. S. 10. W. SE 10. W. No. 1 USA Okey Branch, miles of Wayneboro (distance) (direction) (nearest town)	sand	10	25
WELL PURPOSE: oilfield supply (home, irrigation, municipal, industrial)	clay, small sand	25	105
WELL COMPLETION DATA:	streaked clay, sand	105	200
(1) diameter (inches) 3"	sand, gravel	200	294
(2) total depth (feet) 336'	streaked, little sand	294	336
(3) static water level (feet) 100' below top of ground.			
(4) casing steel 294' (material) (depth) 3" (size) If telescope see back.			
(5) screen 42' 294' (length) (depth to top) 3" perforated (size) (material)			
(6) pump - 70 (HP) (yield gpm) AC (type power)			
(7) electric log (yes or no)			
(organization running log)			
(8) how well bottom plugged orange peel			
DRILLERS REMARKS:			

RECEIVED
SEP 23 1985

If well telescopes please sketch and show depths.

GROUND LEVEL

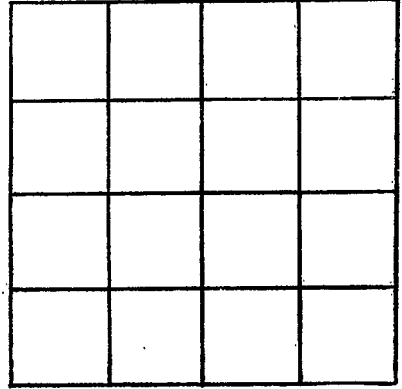

SECTION _____

Please indicate well location X.

ADDITIONAL INFORMATION

If more than one screen,
show locations of each on sketch.