

WAYNE
W 2001
3-25-77

MISSISSIPPI
BOARD OF WATER COMMISSIONERS
416 North State Street
Jackson, Mississippi 39201

WATER WELL DRILLERS LOG

McILWAIN WATER WELL SERVICE

March 25 1977
date well completed

RT. 6 BOX 37
firm name
WAYNESBORO, MISS. 39367


Wayne
county well located

LANDOWNER:	description of formations encountered	from	to
Wiley Newell			
Waynesboro Miss (mailing address)	Sand	0	4
WELL LOCATION:	Clay	4	16
sec. 9 T. 6 N R. 8 W	Sand	16	18
10 miles SW of Clara (distance) (direction) (nearest town)	Clay	18	33
WELL PURPOSE: Home (home, irrigation, municipal, industrial)	Sand	35	40
WELL COMPLETION DATA:			
(1) diameter (inches) 2"			
(2) total depth (feet) 40'			
(3) static water level (feet) 32' below top of ground.			
(4) casing PVC 35' (material) (depth)			
2" if telescope see back. (size)			
(5) screen 5' 35' (length) (depth to top)			
2" PVC .008 (size) (material)			
(6) pump 1/2 10 (HP) (yield gpm)			
110 AC (type power)			
(7) electric log No (yes or no)			
(organization running log)			
(8) how well bottom plugged			
DRILLERS REMARKS:			

MAY 31 1977
MISS. BD. OF WATER COMMISSIONERS

If well telescopes please sketch and show depths.

GROUND LEVEL

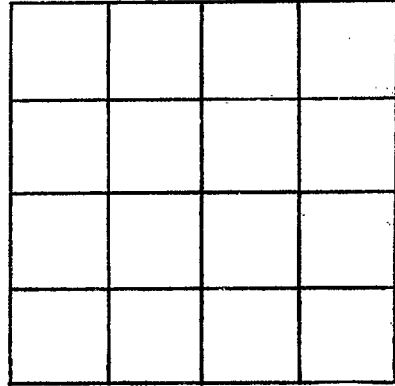

SECTION _____

Please indicate well location X.

ADDITIONAL INFORMATION

If more than one screen, show locations of each on sketch.