

WAYNE

W

7-27-78

MISSISSIPPI BOARD OF WATER COMMISSIONERS
416 North State Street
Jackson, Mississippi 39201

WATER WELL DRILLERS LOG

July 27 1978 Porter Drilling Wayne
date well completed firm name county well located

LANDOWNER: J. B. Brewer

Box 653
Waynesboro Miss
(mailing address)

WELL LOCATION:

sec 35 T 6 N R 8 E
S W
9 miles S of Clara
(distance) (direction) (nearest town)

WELL PURPOSE: home
(home, irrigation, municipal, industrial)

WELL COMPLETION DATA:

- (1) diameter (inches) 2
- (2) total depth (feet) 110'
- (3) static water level (feet) 87 below top of ground.
- (4) casing PVC 105'
(material) (depth)
2' If telescope see back.
(size)
- (5) screen 5' 105'
(length) (depth to top)
2" below 5.5'
(size) (material)
- (6) pump 1 1/2 8
(HP) (yield gpm)
elec.
(type power)
- (7) electric log no
(yes or no)

(organization running log)

(8) how well bottom plugged 2" back wash valve

DRILLERS REMARKS:

description of formations encountered	from	to
sand & clay	0	35
thin rock		35
clay	35	52
thin rock		52
fine sand	52	67
sand & clay	67	85
clay & sand	85	90
sand	90	111
clay & sand	111	115


102' 1" PVC pipe
pipe

RECEIVED
SEP 14 1978

MISS. Bd. OF WATER COMMISSIONERS

If well telescopes please sketch and show depths.

GROUND LEVEL

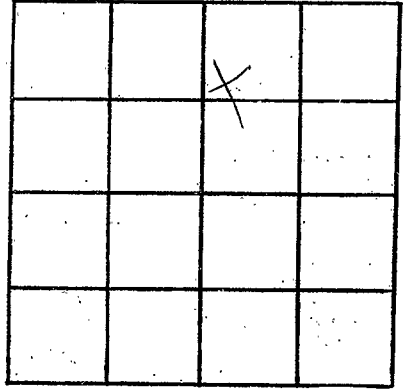

SECTION 35

Please indicate well location X.

ADDITIONAL INFORMATION

If more than one screen, show locations of each on sketch.